

MISSISSIPPI DEPARTMENT OF NATURAL RESOURCES

Bureau of Land and Water Resources

Southport Mall

P.O. Box 10631

Jackson, Mississippi 39209

WATER WELL DRILLERS LOG

Pearl River
P
2082

3/29 1988 Bud Benton Pearl River
 date well completed firm name county well located

LANDOWNER: Wab Carter
R.T. 1 B036 Carrier
Miss. 39426
 (mailing address)

description of formations encountered	from	to
<u>Red shale</u>	<u>0</u>	<u>65</u>
<u>Red Sand</u>	<u>65</u>	<u>105</u>
<u>Blue shale</u>	<u>105</u>	<u>235</u>
<u>Gray Sand</u>	<u>235</u>	<u>285</u>
<u>Blue shale</u>	<u>285</u>	<u>475</u>
<u>Gray Sand</u>	<u>475</u>	<u>530</u>

WELL LOCATION:
 sec. 27 T. 4 N R. 17 E
6 miles West of Carrier
 (distance) (direction) (nearest town)

WELL PURPOSE: home
 (home, irrigation, municipal, industrial)

WELL COMPLETION DATA:

- (1) diameter (inches) 4 1/2"
- (2) total depth (feet) 530
- (3) static water level (feet) 70 below above top of ground.
- (4) casing PVC 530
 (material) (depth)
- 4 1/2 if telescope see back.
 (size)
- (5) screen 10 520
 (length) (depth to top)
- 12 PVC
 (size) (material)
- (6) pump 1 1/2 2 1/2
 (HP) (yield gpm)
- Elect
 (type power)
- (7) electric log no
 (yes or no)
- (organization running log)
- (8) how well bottom plugged Good
Mark


RECEIVED
 APR 29 1988

Department of Natural Resources
 Bureau of Land & Water Resource

DRILLERS REMARKS:

If well telescopes please sketch and show depths.

GROUND LEVEL

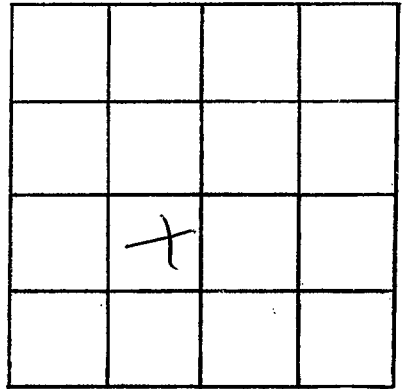

SECTION _____

Please indicate well location X.

ADDITIONAL INFORMATION

If more than one screen, show locations of each on sketch.