

MISSISSIPPI DEPARTMENT OF NATURAL RESOURCES

Bureau of Land and Water Resources

Southport Mall

P.O. Box 10631

Jackson, Mississippi 39209

WATER WELL DRILLERS LOG

P. River
P
2083


4/27/88 19 Bud Penton Pearl River
Date well completed Firm Name county well located
Wells Well Service

LANDOWNER: Vernon Barries description of formations encountered from to
PO Box 159
Mc Neil mas- Red shale 0 10
(mailing address) Sand 10 24
Blue shale 24 180
Gray sand 180 275

WELL LOCATION:
sec. 12 T 4 N R. 17 E
S W
0.1 miles North of McNeal
(distance) (direction) (nearest town)

WELL PURPOSE: drainage or canit.
(home, irrigation, municipal, industrial)

WELL COMPLETION DATA:
(1) diameter (inches) 2"
(2) total depth (feet) 275
(3) static water level (feet) 8 below above
top of ground.
(4) casing PVC, 275
(material) (depth)
(size) if telescope see back.
(5) screen 20, 265
(length) (depth to top)
12, PVC
(size) (material)
(6) pump NO
(HP) (yield gpm)
(type power)
(7) electric log NO
(yes or no)
(organization running log)
(8) how well bottom plugged dry
shale

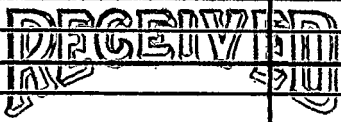

JUN 16 1988

Department of Natural Resources
Bureau of Land & Water Resources

DRILLERS REMARKS: no pump
furnished

If well telescopes please sketch and show depths.

GROUND LEVEL

			X

SECTION _____

Please indicate well location X.

ADDITIONAL INFORMATION

If more than one screen,
show locations of each on sketch.