

MISSISSIPPI DEPARTMENT OF NATURAL RESOURCES

Bureau of Land and Water Resources

Southport Mall

P.O. Box 10631

Jackson, Mississippi 39209

WATER WELL DRILLERS LOG

P. RIVER
P 2085

11/16' 1988 date well completed Pearl River Water Drilling firm name Pearl River county well located

LANDOWNER: James Panther

description of formations encountered

from

to

Post Ranch Dr.

TOP

0 8'

Perryman, MS (mailing address)

Sand & clay mix

9" 10'

Red clay

10 40'

Red & yellow clay

40 65'

Blue clay

65 135'

fine grained sand

135 138'

med & coarse tan sand

138 180'

WELL LOCATION:

sec. 16 T 4 N R 17 E (S) (W) of Perryman (distance) (direction) (nearest town)

WELL PURPOSE: Home (home, irrigation, municipal, industrial)

WELL COMPLETION DATA:

- (1) diameter (inches) 4"
- (2) total depth (feet) 155
- (3) static water level (feet) 70 (below above top of ground)

(4) casing PUC 195 (material) (depth)

(size) if telescope see back.

(5) screen 10' 195 (length) (depth to top)

010 PUC Slot (size) (material)

(6) pump 2 (HP) 12 (yield gpm)

220V (type power)

(7) electric log (yes or no)

(organization running log)

(8) how well bottom plugged SS

RECEIVED


FEB 10 1989

Department of Natural Resources Bureau of Land & Water Resources

DRILLERS REMARKS:

If well telescopes please
sketch and show depths.

GROUND LEVEL

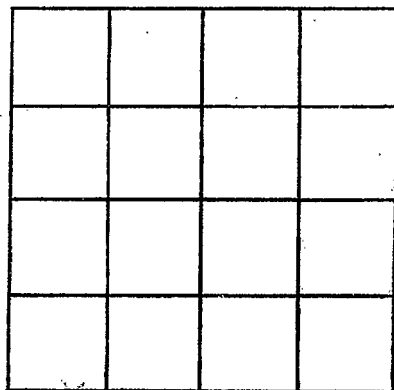

SECTION _____

Please indicate well location X.

ADDITIONAL INFORMATION

If more than one screen,
show locations of each on sketch.