

MISSISSIPPI DEPARTMENT OF NATURAL RESOURCES

Bureau of Land and Water Resources

Southport Mall

P.O. Box 10631

Jackson, Mississippi 39209

WATER WELL DRILLERS LOG

P. RIVER  
P 2087

5/8 1989 Bud Penton Pearl River  
date well completed firm name county well located

LANDOWNERS: Cann Diamond  
R-T. Lore Estate  
Carrier miss.  
(mailing address)

description of formations encountered	from	to
Red shale	0	10
white sand	10	61
Blue shale	61	90
gray sand	90	117
Blue shale	117	160
Blue sand	160	231
Blue shale	231	245
gray sand	245	273
Blue shale	273	345
gray sand	345	457

WELL LOCATION:  
sec. 21 T 4 N R 17 E  
6 miles South of Carrier  
(distance) (direction) (nearest town)

WELL PURPOSE: home  
(home, irrigation, municipal, industrial)

- WELL COMPLETION DATA:
- (1) diameter (inches) 2 7/8
  - (2) total depth (feet) 457
  - (3) static water level (feet) 45 below above top of ground.
  - (4) casing PVC, 457 (material) (depth)  
(size) if telescope see back.
  - (5) screen 10, 447 (length) (depth to top)  
1/2" PVC (size) (material)
  - (6) pump 1 (HP) 10 (yield gpm)  
Elect (type power)
  - (7) electric log no (yes or no)

(organization running log)  
(8) how well bottom plugged  
Shut

DRILLERS REMARKS:


RECEIVED

MAY 24 1989

Department of Natural Resources  
Bureau of Land & Water Resources

If well telescopes please sketch and show depths.

GROUND LEVEL

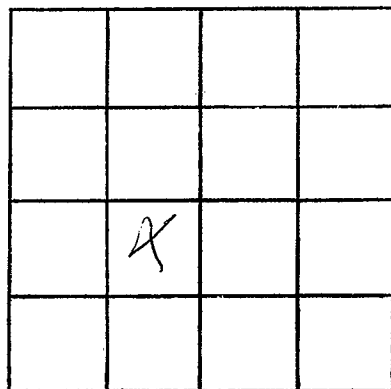

SECTION \_\_\_\_\_

Please indicate well location X.

ADDITIONAL INFORMATION

If more than one screen,  
show locations of each on sketch.