

MISSISSIPPI DEPARTMENT OF NATURAL RESOURCES

Bureau of Land and Water Resources

Southport Mall

P.O. Box 10631

Jackson, Mississippi 39209

WATER WELL DRILLERS LOG

|          |
|----------|
| P. RIVER |
| D 2088   |
|          |
|          |

2/21 1989 Bud Penton Pearl River  
 date well completed firm name county well located

LANDOWNER: Wrayland Spiers R T 4  
Carriere Miss 39406  
 (mailing address)

| description of formations encountered | from | to  |
|---------------------------------------|------|-----|
| Red shale                             | 0    | 10  |
| Red sand                              | 10   | 60  |
| Blue shale                            | 60   | 160 |
| Wray sand                             | 160  | 219 |
| Blue shale                            | 219  | 415 |
| Wray sand                             | 415  | 450 |

WELL LOCATION:  
 sec. 28 T 4 N R 17 E  
3 miles West of Carriere  
 (distance) (direction) (nearest town)

WELL PURPOSE: Home  
 (home, irrigation, municipal, industrial)

- WELL COMPLETION DATA:
- (1) diameter (inches) 2 1/2
  - (2) total depth (feet) 450
  - (3) static water level (feet) 45 below above top of ground.
  - (4) casing PVC, 450,  
 (material) (depth)  
 (size) if telescope see back.
  - (5) screen 10, 440  
 (length) (depth to top)  
12, PVC  
 (size) (material)
  - (6) pump 1, 450  
 (HP) (yield gpm)  
 (type power) 3ph
  - (7) electric log no  
 (yes or no)
  - (organization running log)
  - (8) how well bottom plugged Mark

RECEIVED


MAY 24 1989

Department of Natural Resources  
 Bureau of Land & Water Resources

DRILLERS REMARKS:

If well telescopes please sketch and show depths.

GROUND LEVEL

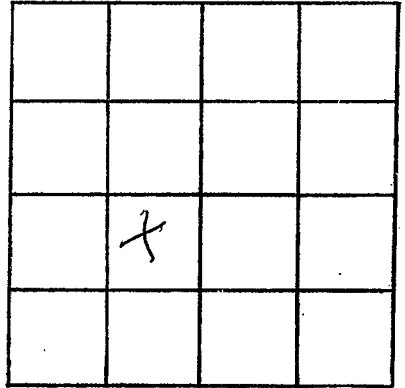

SECTION \_\_\_\_\_

Please indicate well location X.

ADDITIONAL INFORMATION

If more than one screen,  
show locations of each on sketch.