

MISSISSIPPI DEPARTMENT OF NATURAL RESOURCES
 Bureau of Land and Water Resources
 Southport Mall
 P.O. Box 10631
 Jackson, Mississippi 39209
WATER WELL DRILLERS LOG

<u>PRIVER</u>
<u>P008A</u>

2/17 1989 Bud Penton Pearl River
 /date well completed firm name county well located

LANDOWNER: Raymond Sloyer
R-1 Box Carrier
Miss 3942
 (mailing address)

description of formations encountered	from to	
	from	to
<u>Red shale</u>	<u>0</u>	<u>10</u>
<u>White sand</u>	<u>10</u>	<u>50</u>
<u>Blue shale</u>	<u>50</u>	<u>150</u>
<u>Gray sand</u>	<u>150</u>	<u>168</u>

WELL LOCATION:
 sec. 22 T 11 N R. 17 E
 S W
6 miles north of Carrier
 (distance) (direction) (nearest town)

WELL PURPOSE: home
 (home, irrigation, municipal, industrial)

WELL COMPLETION DATA:

- (1) diameter (inches) 2
- (2) total depth (feet) 168
- (3) static water level (feet) 77 below above top of ground.
- (4) casing PVC, 168
 (material) (depth)
no if telescope see back.
 (size)
- (5) screen 10, 158
 (length) (depth to top)
10, PVC
 (size) (material)
- (6) pump 1, 7.5
 (HP) (yield gpm)
Elect
 (type power)
- (7) electric log no
 (yes or no)

(organization running log)
land
mark

(8) how well bottom plugged

DRILLERS REMARKS:


RECEIVED

MAY 24 1989

Department of Natural Resources
 Bureau of Land & Water Resources

If well telescopes please sketch and show depths.

GROUND LEVEL

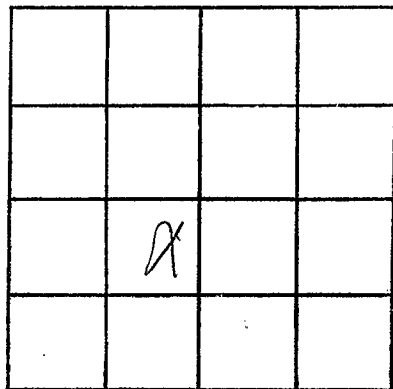

SECTION _____

Please indicate well location X.

ADDITIONAL INFORMATION

If more than one screen,
show locations of each on sketch.