

MISSISSIPPI DEPARTMENT OF NATURAL RESOURCES

Bureau of Land and Water Resources

P.O. Box 10631

Jackson, Mississippi 39209

WATER WELL DRILLERS LOG

COUNTY WELL LOCATED
PEARL RIVER

WELL NUMBER
P

CODED

DATE WELL COMPLETED
6/10/87

PERMIT NUMBER
0428

NAME OF DRILLING FIRM
WALKER'S WELLS

Drilling

NAME & MAILING ADDRESS OF LANDOWNER
Joe R. Rowzee

3504 James Drive

Metairie La. 70003

WELL LOCATION: SEC **17** TOWNSHIP **4** RANGE **N 17 E**

DISTANCE **14** Miles DIRECTION **NORTH** of **PICAYUNE**

OTHER LANDMARK
REDMOND R.D.

WELL PURPOSE Home Irrigation, Municipal, Industrial, Fish Pond, etc.

PUMP DATA

PUMP TYPE (Circle One):
~~Submersible~~ Turbine, Jet, Flowing Well, Other (Describe) _____

POWER TYPE (Circle One):
~~Electric~~ Tractor, Diesel, Gasoline, Butane, Other (Describe) _____

Pump Capacity (GPM) 8	No. of Stages	Setting Depth 8 FT.
---------------------------------	---------------	-------------------------------

PUMP TEST

Well yielded _____ GPM with a drawdown of _____ ft. after _____ hours of pumping

WELL DATA

Well Depth 225	Casing Diameter (In.) 4	Casing Length (Ft.) 225
Type of Casing PVC	Hole Depth 270	Depth to Static Water Level 90

TYPE OF COMPLETION: (Circle One or More):
Gravel Packed, Underreamed, Telescoped, Natural Development, Open Hole, Other (Describe) **AKR**

Top of Lap Pipe or Reduction in Casing
FEET IF TELESCOPED OR MORE THAN ONE SCREEN: USE BACK PAGE

LOG DATA

TYPE OF LOG RUN (Circle One):
No Log Run, Electric, Gamma Ray, Density, Sonic, Neutron, Other (Describe) _____

Name of Organization Running Log _____

SCREEN DATA

Diameter - Inches 4	Length - Feet 10	Slot Size - Inches 1/10
Screen Type SLOT	Depth to Bottom - Feet 225	

GEOLOGIC DATA (Office Use Only)

Surface Elev.	Geologic Unit	Unit Thickness	Depth to Top
Subs. SWL	Date	Analysis	Aquifer Test

Driller's Remarks

RECEIVED


DESCRIPTION OF FORMATIONS ENCOUNTERED	FROM	TO	FORMATIONS (Continued)	FROM	TO
CLAY	0	20	JUL 05 1987		
SAND	20	30			
BLUE CLAY	30	120			
SAND	120	140			
BLUE CLAY	200	201			
SAND	200	230			
LOSS	230	250			
SAND	250	270			

Department of Natural Resources
Bureau of Land & Water Resources

IF MORE SPACE IS NEEDED, USE BACK

If well telescopes please sketch and show depths.

GROUND LEVEL

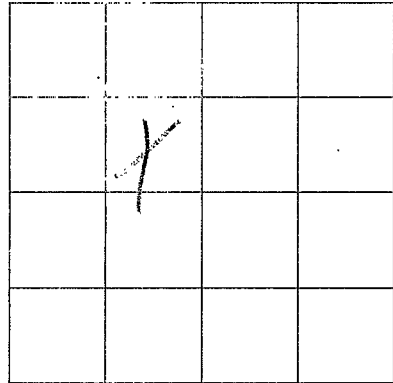

SECTION _____

Please indicate well location X.

ADDITIONAL INFORMATION

If more than one screen,
show location of each on sketch.