

MISSISSIPPI DEPARTMENT OF NATURAL RESOURCES

Bureau of Land and Water Resources

Southport Mall

P.O. Box 10631

Jackson, Mississippi 39209

WATER WELL DRILLERS LOG

P. River
Pa095

8/18 1989 Bad Pentastar Pearl River
date well completed firm name county well located


LANDOWNER: Delmy Insult
R.T. Lopez 130 K
Carroll Miss
(mailing address)

description of formations encountered	from	to
<u>Red shale</u>	<u>0</u>	<u>20</u>
<u>Red sand</u>	<u>20</u>	<u>81</u>
<u>Blue shale</u>	<u>81</u>	<u>180</u>
<u>Grey sand</u>	<u>180</u>	<u>208</u>

WELL LOCATION:
sec. 21 T 4 N R 17 E
S W
6 miles west of Carroll
(distance) (direction) (nearest town)

WELL PURPOSE: Home
(home, irrigation, municipal, industrial)

- WELL COMPLETION DATA:
- (1) diameter (inches) 2"
 - (2) total depth (feet) 208
 - (3) static water level (feet) 99 below above top of ground.
 - (4) casing mc 208
(material) (depth)
(size) if telescope see back.
 - (5) screen 5' 203
(length) (depth to top)
12 mc
(size) (material)
 - (6) pump 1 350
(HP) (yield gpm)
Elect
(type power)
 - (7) electric log NO
(yes or no)

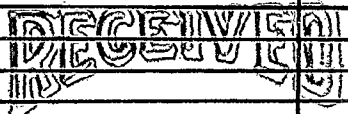

JAN 26 1990


Department of Natural Resources
Bureau of Land & Water Resources

(organization running log)
(8) how well bottom plugged Good
Start

DRILLERS REMARKS:

If well telescopes please sketch and show depths.

GROUND LEVEL

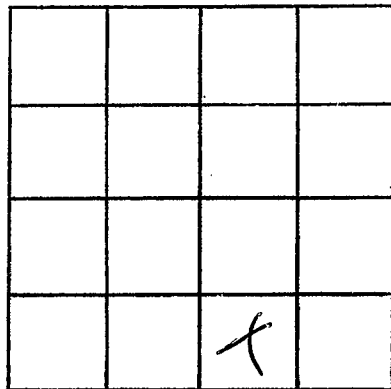

SECTION _____

Please indicate well location X.

ADDITIONAL INFORMATION

If more than one screen,
show locations of each on sketch.