

**MISSISSIPPI DEPARTMENT OF NATURAL RESOURCES**  
**Bureau of Land and Water Resources**  
 Southport Mall  
 P.O. Box 10631  
 Jackson, Mississippi 39209  
**WATER WELL DRILLERS LOG**

P. River  
P 2078

9/6 1989 Bud Penton & Son Pearl River  
 date well completed firm name county well located

LANDOWNER: <u>Square Meaty</u>	description of formations encountered	from	to
<u>PO Box 133 Carriere, Miss</u> <u>39426</u> (mailing address)	<u>white shale</u>	<u>0</u>	<u>148</u>
	<u>Blas sand no good</u>	<u>148</u>	<u>175</u>
	<u>Blue shale</u>	<u>175</u>	<u>276</u>
	<u>Grey sand</u>	<u>276</u>	<u>300</u>

**WELL LOCATION:**  
 sec. 22 T 4 N R 17 E  
                   S                                    W  
6 miles West of McNeil  
 (distance) (direction) (nearest town)


**WELL PURPOSE:** home  
 (home, irrigation, municipal, industrial)

- WELL COMPLETION DATA:**
- (1) diameter (inches) 2
  - (2) total depth (feet) 300
  - (3) static water level (feet) 70 below/above top of ground.
  - (4) casing PVC 300  
 (material) (depth)  
 (size) if telescope see back.
  - (5) screen 5 295  
 (length) (depth to top)  
12 PVC  
 (size) (material)
  - (6) pump 1 450  
 (HP) (yield gpm)  
Elect  
 (type power)
  - (7) electric log no  
 (yes or no)
  - (organization running log)
  - (8) how well bottom plugged hard  
shale

**DRILLERS REMARKS:**

If well telescopes please sketch and show depths.

GROUND LEVEL

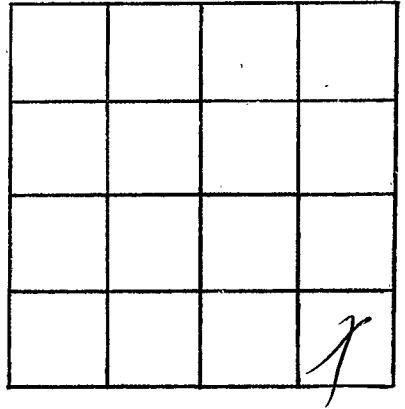

SECTION \_\_\_\_\_

Please indicate well location X.

ADDITIONAL INFORMATION

If more than one screen,  
show locations of each on sketch.