

**MISSISSIPPI DEPARTMENT OF NATURAL RESOURCES**  
 Bureau of Land and Water Resources  
 Southport Mall  
 P.O. Box 10631  
 Jackson, Mississippi 39209  
**WATER WELL DRILLERS LOG**

P. RIVER  
P2100

10/9 1989 Bad Penton & Son Pearl River  
 date well completed firm name county well located


LANDOWNER: Billy Lewis  
PO Box 595 Pearl River  
Miss. 39572  
 (mailing address)

description of formations encountered	from	to
<u>Red Shale</u>	<u>0</u>	<u>25</u>
<u>Red Sand</u>	<u>25</u>	<u>30</u>
<u>Blue Shale</u>	<u>50</u>	<u>220</u>
<u>Gray Sand</u>	<u>220</u>	<u>305</u>

WELL LOCATION:  
 sec. 21 T 4 N R 17 E  
                   S                  W  
6 miles West of Carriere  
 (distance) (direction) (nearest town)

WELL PURPOSE: Home  
 (home, irrigation, municipal, industrial)

- WELL COMPLETION DATA:
- (1) diameter (inches) 4"
  - (2) total depth (feet) 305
  - (3) static water level (feet) 120 below above top of ground.
  - (4) casing PVC, 305  
 (material) (depth)  
 (size) If telescope see back.
  - (5) screen 10, 295  
 (length) (depth to top)  
2, PVC  
 (size) (material)
  - (6) pump NO  
 (HP) (yield gpm)  
0  
 (type power)
  - (7) electric log NO  
 (yes or no)

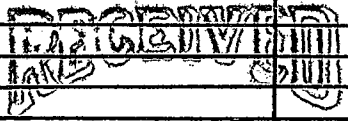

(organization running log)  
 (8) how well bottom plugged Sand  
Shale


DRILLERS REMARKS:

If well telescopes please sketch and show depths.

GROUND LEVEL

200 ft. 4"

105 ft. 2 1/4"

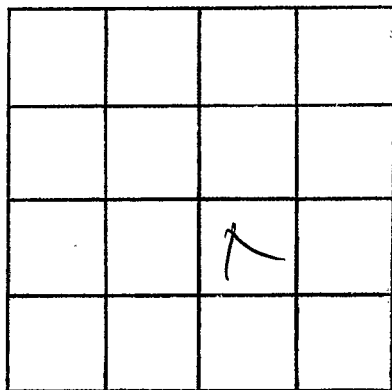

SECTION \_\_\_\_\_

Please indicate well location X.

ADDITIONAL INFORMATION

If more than one screen, show locations of each on sketch.