

MISSISSIPPI DEPARTMENT OF NATURAL RESOURCES

Bureau of Land and Water Resources

Southport Mall

P.O. Box 10631

Jackson, Mississippi 39209

WATER WELL DRILLERS LOG

P. RIVER
P 2101

6/7 1989 Bud Penton & Sons Jackson
date well completed firm name county well located

LANDOWNER: Kenneth Mallett PO Box 642
McNeil Miss
(mailing address)

description of formations encountered	from	to
<u>Red shale</u>	<u>0</u>	<u>35</u>
<u>Red sand</u>	<u>35</u>	<u>43</u>
<u>Blue shale</u>	<u>43</u>	<u>135</u>
<u>Shay sand</u>	<u>135</u>	<u>158</u>

WELL LOCATION:
sec. 22 T 4 N R 17 E
S W
4 miles W of McNeil
(distance) (direction) (nearest town)


WELL PURPOSE: home
(home, irrigation, municipal, industrial)

- WELL COMPLETION DATA:
- (1) diameter (inches) 2"
 - (2) total depth (feet) 158
 - (3) static water level (feet) 46 ^{below} / _{above} top of ground.
 - (4) casing PVC, 158
(material) (depth)
 - no if telescope see back.
(size)
 - (5) screen 2x5, 153
(length) (depth to top)
 - 12, PVC
(size) (material)
 - (6) pump 1 450
(HP) (yield gpm)
 - Electric
(type power)
 - (7) electric log no
(yes or no)

(organization running log)


(8) how well bottom plugged: hard
sharp

DRILLERS REMARKS:

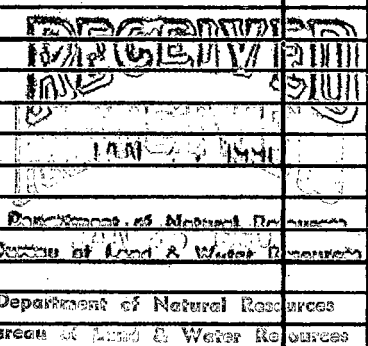

If well telescopes please sketch and show depths.

GROUND LEVEL

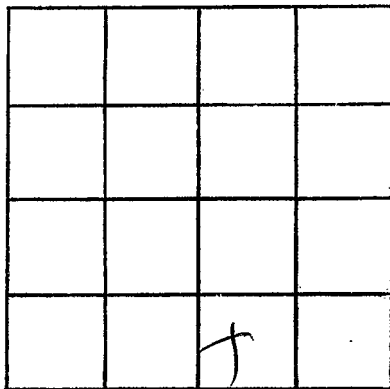

SECTION _____

Please indicate well location X.

ADDITIONAL INFORMATION

If more than one screen,
show locations of each on sketch.