

P. RIVER
P 2105

MISSISSIPPI DEPARTMENT OF NATURAL RESOURCES
Bureau of Land and Water Resources
Southport Mall
P.O. Box 10631
Jackson, Mississippi 39209
WATER WELL DRILLERS LOG

6/29/90 1990 Bud Penton Pearl River
date well completed firm name county well located

LANDOWNER: Robert W. Runney
RT-4 Box 580
Pocahontas
(mailing address)

description of formations encountered	from	to
Red shale	0	30
Red sand	30	73

WELL LOCATION:
sec 20 T 4 N R 17 E
S W
6 miles West of Carroll
(distance) (direction) (nearest town)

WELL PURPOSE: home
(home, irrigation, municipal, industrial)

WELL COMPLETION DATA:

- (1) diameter (inches) 4"
- (2) total depth (feet) 73
- (3) static water level (feet) 40 below top of ground
- (4) casing PVC, 73 (depth)
- (5) screen 10 (length), 6.3 (depth to top), 10 (size), PVC (material)
- (6) pump NO (HP), (yield gpm)
- (7) electric log NO (yes or no)
- (8) how well bottom plugged


RECEIVED
OCT 15 1990

Department of Natural Resources
Bureau of Land & Water Resources

DRILLERS REMARKS:

If well telescopes please sketch and show depths.

GROUND LEVEL

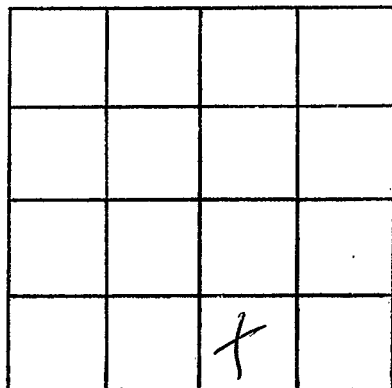

SECTION _____

Please indicate well location X.

ADDITIONAL INFORMATION

If more than one screen,
show locations of each on sketch.