

P. River  
Pasco

MISSISSIPPI DEPARTMENT OF NATURAL RESOURCES  
Bureau of Land and Water Resources  
Southport Mall  
P.O. Box 10631  
Jackson, Mississippi 39209  
WATER WELL DRILLERS LOG

8/27 1990 Bud Perton Pearl River  
date well completed firm name county well located

LANDOWNER: Egen Bohart  
Virgil Lewis Rd  
(mailing address)

description of formations encountered	from	to
Reddish Lt Blue	@ 198	
Grey sand	198	258
Blue shale	258	388
Grey sand	388	410
Blue shale	410	445
Grey sand	445	570

WELL LOCATION:  
sec. 13 T 4 N R 17 E  
S S W  
5 miles W of Carrieville  
(distance) (direction) (nearest town)

WELL PURPOSE: home  
(home, irrigation, municipal, industrial)

WELL COMPLETION DATA:

- (1) diameter (inches) 2
- (2) total depth (feet) 570
- (3) static water level (feet) 40 below top of ground.
- (4) casing PVC 570 (material) (depth)
- (5) screen 10 500 (length) (depth to top)  
12 PVC (size) (material)
- (6) pump 1 6 (HP) (yield gpm)  
Elect (type power)
- (7) electric log NO (yes or no)
- (8) how well bottom plugged sand


RECEIVED  
OCT 15 1990

Department of Natural Resources  
Bureau of Land & Water Resources

DRILLERS REMARKS:

If well telescopes please  
sketch and show depths.

GROUND LEVEL

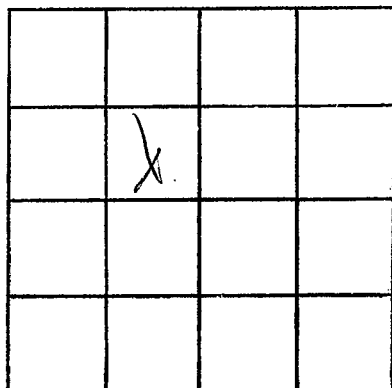

SECTION \_\_\_\_\_

Please indicate well location X.

ADDITIONAL INFORMATION

If more than one screen,  
show locations of each on sketch.