

MISSISSIPPI DEPARTMENT OF NATURAL RESOURCES

Bureau of Land and Water Resources

Southport Mall

P.O. Box 10631

Jackson, Mississippi 39209

WATER WELL DRILLERS LOG

P. Owen
P 2107
8/1
8/1

date well completed

19 90 Budgenton

firm name

pearl River
county well located


LANDOWNER:	description of formations encountered	from	to
<u>E.W. Crowley</u>	<u>Red Shale</u>	<u>0</u>	<u>15'</u>
<u>R.T. 3 Box 145 B</u>	<u>Blue Sand</u>	<u>15'</u>	<u>135'</u>
<u>Carriere Miss.</u>	<u>Blue Shale</u>	<u>135'</u>	<u>245'</u>
(mailing address)	<u>Gray Sand</u>	<u>245'</u>	<u>260'</u>
WELL LOCATION:			
sec. <u>22</u> T. <u>4</u> N. R. <u>17</u> E			
S. <u>6</u> miles <u>W</u> of <u>Carriere</u>			
(distance) (direction) (nearest town)			
WELL PURPOSE: <u>home</u>			
(home, irrigation, municipal, industrial)			
WELL COMPLETION DATA:			
(1) diameter (inches) <u>2"</u>			
(2) total depth (feet) <u>260</u>			
(3) static water level (feet) <u>24</u> below/above top of ground.			
(4) casing <u>4" PVC</u> <u>260</u>			
(material) (depth)			
(size) if telescope see back.			
(5) screen <u>10</u> <u>250</u>			
(length) (depth to top)			
<u>8</u> <u>PVC</u>			
(size) (material)			
(6) pump <u>1</u> <u>5</u>			
(HP) (yield gpm)			
<u>Elect</u>			
(type power)			
(7) electric log <u>no</u>			
(yes or no)			
(organization running log)			
(8) how well bottom plugged <u>sharp</u>			
DRILLERS REMARKS:			

RECEIVED
OCT 15 1990

Department of Natural Resources
Bureau of Land & Water

If well telescopes please
sketch and show depths.

GROUND LEVEL

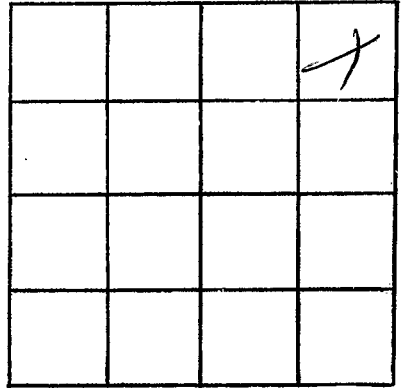

SECTION _____

Please indicate well location X.

ADDITIONAL INFORMATION

If more than one screen,
show locations of each on sketch.