

P. RIVER
P 2158

MISSISSIPPI DEPARTMENT OF NATURAL RESOURCES

Bureau of Land and Water Resources

Southport Mall

P.O. Box 10631

Jackson, Mississippi 39209

WATER WELL DRILLERS LOG

8/1 1990 Bed Perfor Pearl River
 date well completed firm name county well located

LANDOWNER: Gene Senery
R.T-1 Box
Carriere miss.
 (mailing address)

description of formations encountered	from	to
<u>Red shale</u>	<u>0</u>	<u>18</u>
<u>White sand</u>	<u>18</u>	<u>58</u>
<u>Blue shale</u>	<u>58</u>	<u>130</u>
<u>Blue sand</u>	<u>130</u>	<u>265</u>
<u>Blue shale</u>	<u>265</u>	<u>325</u>
<u>Gray sand</u>	<u>325</u>	<u>480</u>

WELL LOCATION:
 sec. 20 T 4 N R. 17 E
6 miles W of Carriere
 (distance) (direction) (nearest town)

WELL PURPOSE: Home
 (home, irrigation, municipal, industrial)

WELL COMPLETION DATA:

- (1) diameter (inches) 2
- (2) total depth (feet) 480
- (3) static water level (feet) 23 below above top of ground.
- (4) casing pvc 480
 (material) (depth)
 (size) If telescope see back.
- (5) screen 10 470
 (length) (depth to top)
10 pvc
 (size) (material)
- (6) pump 1/2 5
 (HP) (yield gpm)
Elect
 (type power)
- (7) electric log no
 (yes or no)
 (organization running log)
- (8) how well bottom plugged sand
shale


DRILLERS REMARKS:

RECEIVED
 AL
 OCT 15 1990

Department of Natural Resources
 Bureau of Land & Water Resources

If well telescopes please sketch and show depths.

GROUND LEVEL

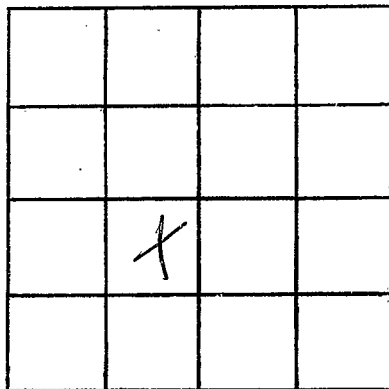

SECTION _____

Please indicate well location X.

ADDITIONAL INFORMATION

If more than one screen,
show locations of each on sketch.