

MISSISSIPPI DEPARTMENT OF NATURAL RESOURCES

Bureau of Land and Water Resources

Southport Mall

P.O. Box 10631

Jackson, Mississippi 39209

WATER WELL DRILLERS LOG

P. RIVER
P 2109

12-3 date well completed 19 90 Badenton firm name Pearl River county well located

LANDOWNER: Fredrick Spier
R.T. 4 Box 552
Carrieville Miss.
(mailing address)

WELL LOCATION:
sec 32 T 4 N R 17 E
S W
6 miles West of Carrieville
(distance) (direction) (nearest town)

WELL PURPOSE: None
(home, irrigation, municipal, industrial)

- WELL COMPLETION DATA:
- (1) diameter (inches) 2"
 - (2) total depth (feet) 470
 - (3) static water level (feet) 90 below above top of ground.
 - (4) casing pvc 470
(material) (depth)
(size) if telescope see back.
 - (5) screen 10 460
(length) (depth to top)
12 pvc
(size) (material)
 - (6) pump no
(HP) (yield gpm)
(type power)
 - (7) electric log no
(yes or no)
(organization running log)
 - (8) how well bottom plugged Sand
hard

description of formations encountered	from	to
<u>Red Shale</u>	<u>0</u>	<u>10</u>
<u>Red Sand</u>	<u>10</u>	<u>75</u>
<u>Blue Shale</u>	<u>75</u>	<u>180</u>
<u>Gray Sand</u>	<u>180</u>	<u>375</u>
<u>Blue Shale</u>	<u>375</u>	<u>380</u>
<u>Gray Sand</u>	<u>38</u>	<u>470</u>


RECEIVED
FEB 9 1991

Dept. of Environmental Quality
Bureau of Land & Water Resources

DRILLERS REMARKS:

If well telescopes please sketch and show depths.

GROUND LEVEL

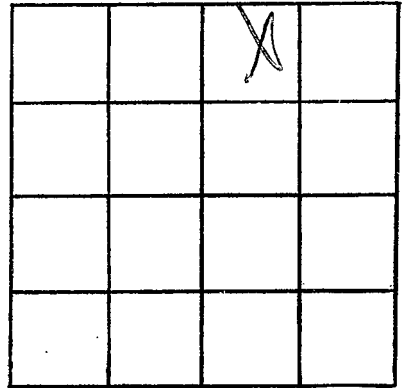

SECTION _____

Please indicate well location X.

ADDITIONAL INFORMATION

If more than one screen,
show locations of each on sketch.