

MISSISSIPPI DEPARTMENT OF NATURAL RESOURCES

Bureau of Land and Water Resources

Southport Mall

P.O. Box 10631

Jackson, Mississippi 39209

WATER WELL DRILLERS LOG

P. River
P 2110

1/12 1990 Bud Denton Pearl River
date well completed firm name county well located

LANDOWNER: <u>Saura Shell</u>	description of formations encountered	from	to
<u>RT. 1. Box 140 Carrier</u>			
<u>Miss.</u>	<u>Red soil</u>	<u>0</u>	<u>30</u>
(mailing address)	<u>Red sand</u>	<u>30</u>	<u>70</u>

WELL LOCATION:
sec. 29 T. 4 N. R. 17 E
6 miles W of Carrier
(distance) (direction) (nearest town)

WELL PURPOSE: Home
(home, irrigation, municipal, industrial)

- WELL COMPLETION DATA:
- (1) diameter (inches) 2"
 - (2) total depth (feet) 90
 - (3) static water level (feet) 25 below top of ground.
 - (4) casing pvc, 90,
(material) (depth)
(size) If telescope see back.
 - (5) screen 5, 85
(length) (depth to top)
12, pvc
(size) (material)
 - (6) pump 1/2, 350
(HP) (yield gpm)
Elect.
(type power)
 - (7) electric log no
(yes or no)
 - (organization running log)
 - (8) how well bottom plugged hard

RECEIVED


FEB 19 1990

Dept. of Environmental Quality
Bureau of Land & Water Resources

DRILLERS REMARKS:

If well telescopes please sketch and show depths.

GROUND LEVEL

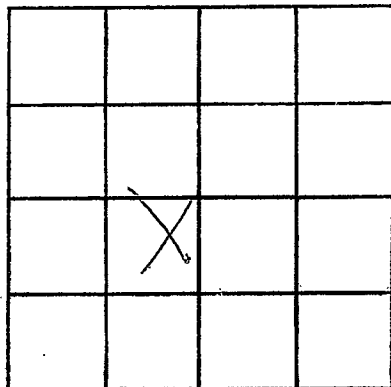

SECTION _____

Please indicate well location X.

ADDITIONAL INFORMATION

If more than one screen, show locations of each on sketch.