

MISSISSIPPI DEPARTMENT OF NATURAL RESOURCES

Bureau of Land and Water Resources

Southport Mall

P.O. Box 10631

Jackson, Mississippi 39209

WATER WELL DRILLERS LOG

Pearl River
P 2111

1/16 19 92 Pearl Penton Pearl River
date well completed firm name county well located

LANDOWNER: J. C. Sommers
Sumner Ocean Rd
Parow ac
(mailing address)

WELL LOCATION:
sec 15 T 4 N R 17 E
S W
6 miles West of Carroll
(distance) (direction) (nearest town)

WELL PURPOSE: home
(home, irrigation, municipal, industrial)

WELL COMPLETION DATA:

(1) diameter (inches) 2"

(2) total depth (feet) 685

(3) static water level (feet) 461 below above top of ground.

(4) casing PCC, 685,
(material) (depth)

(size) if telescope see back.

(5) screen 10, 675
(length) (depth to top)

12, PCC
(size) (material)

(6) pump NO
(HP) (yield gpm)


NO
(type power)

(7) electric log NO
(yes or no)

(organization running log)

(8) how well bottom plugged Sand
Shale

description of formations encountered	from	to
<u>Red shale</u>	<u>0</u>	<u>115</u>
<u>Blue sand</u>	<u>115</u>	<u>147</u>
<u>Blue shale</u>	<u>147</u>	<u>170</u>
<u>Gray sand</u>	<u>170</u>	<u>209</u>
<u>Blue shale</u>	<u>209</u>	<u>245</u>
<u>Gray sand</u>	<u>245</u>	<u>287</u>
<u>Blue shale</u>	<u>287</u>	<u>375</u>
<u>Gray sand</u>	<u>375</u>	<u>685</u>

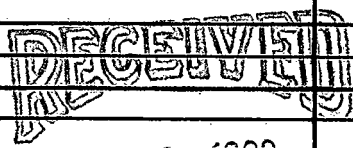


APR 29 1992

Dept. of Environmental Quality
Bureau of Land & Water Resources

DRILLERS REMARKS: NO pump
furnished

If well telescopes please
sketch and show depths.

GROUND LEVEL

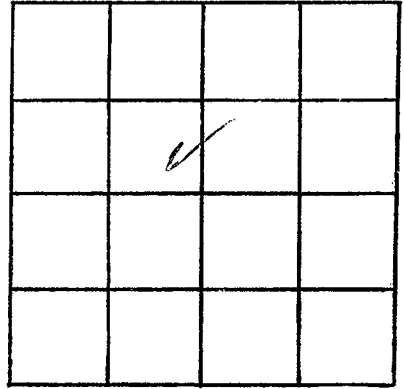

SECTION 15-

Please indicate well location X.

ADDITIONAL INFORMATION

If more than one screen,
show locations of each on sketch.