

## MISSISSIPPI DEPARTMENT OF NATURAL RESOURCES

Bureau of Land and Water Resources

Southport Mall

P.O. Box 10631

Jackson, Mississippi 39209

## WATER WELL DRILLERS LOG

5/13 1992 Bed poston well near Pearl River  
 date well completed firm name county well located

LANDOWNER: Paul Jackson

description of formations encountered

from to

R.T. 4 Vigne LureRed shale0 18Rd

(mailing address)

Red sand18 42Blue shale42 135Gray sand135 255Blue shale255 357Gray sand357 400Blue shale400 430Gray sand430 484

WELL LOCATION:

sec 32 T 4 N R 17 E  
 S W W  
4 miles W of Corrigan  
 (distance) (direction) (nearest town)

WELL PURPOSE: home  
 (home, irrigation, municipal, industrial)

## WELL COMPLETION DATA:

- (1) diameter (inches) 2  
 (2) total depth (feet) 484  
 (3) static water level (feet) 46 below above  
 top of ground.  
 (4) casing PVC 484  
 (material) (depth)

(size) if telescope see back.

- (5) screen 10 474  
 (length) (depth to top)  
12 PVC  
 (size) (material)

- (6) pump 1 12  
 (HP) (yield gpm)

Elect  
 (type power)

- (7) electric log no  
 (yes or no)

(organization running log)

- (8) how well bottom plugged hard  
hard

DRILLERS REMARKS:


RECEIVED

JUN 08 1992

Dept. of Environmental Quality  
 Bureau of Land & Water Resources

If well telescopes please  
sketch and show depths.

GROUND LEVEL

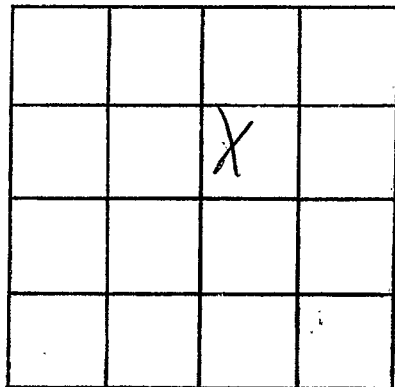

SECTION \_\_\_\_\_

Please indicate well location X.

ADDITIONAL INFORMATION

If more than one screen,  
show locations of each on sketch.