

MISSISSIPPI DEPARTMENT OF NATURAL RESOURCES

Bureau of Land and Water Resources

Southport Mall

P.O. Box 10631

Jackson, Mississippi 39209

WATER WELL DRILLERS LOG

Adair River
P 2514

5/19 date well completed 1992 Bud P.enton firm name pearl River county well located

LANDOWNER: Hurkel Louster
Larow Rd Carriev
Miss
(mailing address)

WELL LOCATION:
sec. 22 T 4 N R 17 E
6 miles SW of Carriev
(distance) (direction) (nearest town)

WELL PURPOSE: home
(home, irrigation, municipal, industrial)

WELL COMPLETION DATA:

(1) diameter (inches) 4 X 2
(2) total depth (feet) 709
(3) static water level (feet) 69 below top of ground.
(4) casing pcu, 709 (material) (depth)
4 X 2 (size) if telescope see back.
(5) screen 10, 699 (length) (depth to top)
12, pcu (size) (material)
(6) pump 1 (HP) 20 (yield gpm)
Elect (type power)
(7) electric log no (yes or no)
(organization running log)
(8) how well bottom plugged sharp

description of formations encountered	from	to
<u>Blue shale</u>	<u>0</u>	<u>160</u>
<u>Gray sand</u>	<u>160</u>	<u>180</u>
<u>Blue shale</u>	<u>180</u>	<u>223</u>
<u>Gray sand</u>	<u>225</u>	<u>327</u>
<u>Blue shale</u>	<u>327</u>	<u>460</u>
<u>Blue sand gravel</u>	<u>460</u>	<u>500</u>
<u>Blue shale</u>	<u>500</u>	<u>627</u>
<u>Gray sand</u>	<u>627</u>	<u>709</u>

RECEIVED
JUN 08 1992


Dept. of Environmental Quality
Bureau of Land & Water Resources

DRILLERS REMARKS:

If well telescopes please sketch and show depths.

GROUND LEVEL

549-2" | 160ft 4

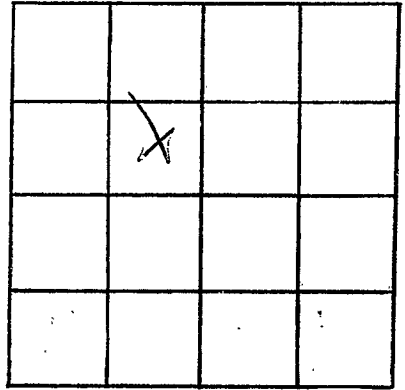

SECTION _____

Please indicate well location X.

ADDITIONAL INFORMATION

If more than one screen, show locations of each on sketch.