

MISSISSIPPI DEPARTMENT OF NATURAL RESOURCES

Bureau of Land and Water Resources

Southport Mall

P.O. Box 10631

Jackson, Mississippi 39209

WATER WELL DRILLERS LOG

Pearl River
P 215

5/29 1992 Bud Penton Pearl River
 date well completed firm name county well located

LANDOWNER: Lisa Robicheaux
Lorow part R d
Carrick m to
 (mailing address)

description of formations encountered	from	to
<u>Shale</u>	<u>0</u>	<u>135</u>
<u>Brk sand</u>	<u>135</u>	<u>152</u>
<u>Blue shale</u>	<u>152</u>	<u>189</u>
<u>Blue sand</u>	<u>189</u>	<u>231</u>

WELL LOCATION:
 sec. 22 T 4 N R. 17 E
8 miles SW of Carrick
 (distance) (direction) (nearest town)

WELL PURPOSE: home
 (home, irrigation, municipal, industrial)

- WELL COMPLETION DATA:
- (1) diameter (inches) 2"
 - (2) total depth (feet) 231
 - (3) static water level (feet) 10 below above top of ground.
 - (4) casing pcc 231,
 (material) (depth)
 (size) if telescope see back.
 - (5) screen 10 221
 (length) (depth to top)
10 pcc
 (size) (material)
 - (6) pump 1 6
 (HP) (yield gpm)
Elect
 (type power)
 - (7) electric log no
 (yes or no)

(organization running log)
 (8) how well bottom plugged and
stuck

DRILLERS REMARKS:


RECEIVED

JUN 08 1992

Dept. of Environmental Quality
 Bureau of Land & Water Resources

If well telescopes please sketch and show depths.

GROUND LEVEL

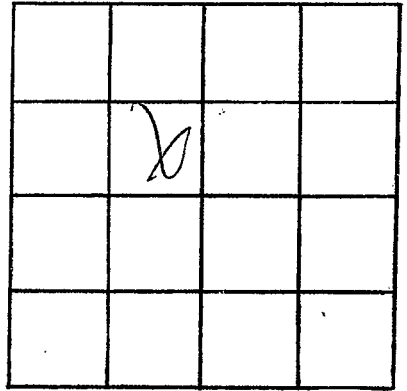

SECTION _____

Please indicate well location X.

ADDITIONAL INFORMATION

If more than one screen,
show locations of each on sketch.