

MISSISSIPPI DEPARTMENT OF NATURAL RESOURCES

Bureau of Land and Water Resources

Southport Mall

P.O. Box 10631

Jackson, Mississippi 39209

WATER WELL DRILLERS LOG

Paul River  
D DLK

5/7 1992 audperentson Paul River  
 date well completed firm name county well located

LANDOWNER: Bruce Warner  
R.T. H Spiers Rd  
 (mailing address)

WELL LOCATION:  
 sec 15 T 4 N R 17 E  
7 miles NW of Carriev  
 (distance) (direction) (nearest town)

WELL PURPOSE: home  
 (home, irrigation, municipal, industrial)

WELL COMPLETION DATA:


- (1) diameter (inches) 2"
- (2) total depth (feet) 687
- (3) static water level (feet) 37 below above top of ground.
- (4) casing pvc 687  
 (material) (depth)
- (size) If telescope see back.
- (5) screen 10 677  
 (length) (depth to top)
- 12 pvc  
 (size) (material)
- (6) pump 1 420  
 (HP) (yield gpm)
- Elect  
 (type power)
- (7) electric log no  
 (yes or no)

(organization running log)

(8) how well bottom plugged sand  
stone

DRILLERS REMARKS:

description of formations encountered	from	to
<u>Red Shell</u>	<u>0</u>	<u>135</u>
<u>Gray sand</u>	<u>135</u>	<u>192</u>
<u>Blue Shell</u>	<u>192</u>	<u>250</u>
<u>Blue sand</u>	<u>250</u>	<u>320</u>
<u>Blue Shell</u>	<u>320</u>	<u>610</u>
<u>Gray sand</u>	<u>610</u>	<u>687</u>

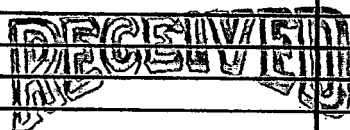


MAY 26 1992

Dept. of Environmental Quality  
 Bureau of Land & Water Resources

If well telescopes please sketch and show depths.

GROUND LEVEL

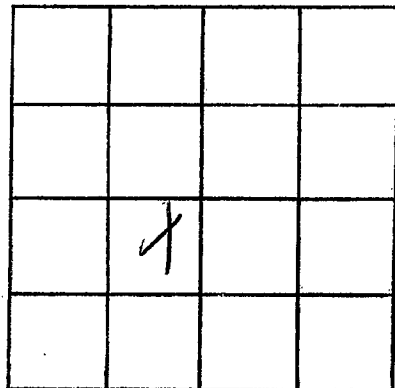

SECTION \_\_\_\_\_

Please indicate well location X.

ADDITIONAL INFORMATION

If more than one screen,  
show locations of each on sketch.