

MISSISSIPPI DEPARTMENT OF NATURAL RESOURCES

Bureau of Land and Water Resources

Southport Mall

P.O. Box 10631

Jackson, Mississippi 39209

WATER WELL DRILLERS LOG

Pearl River
7 2117

4/22-92 19 Bud Denton & Son Pearl River
(date well completed) (firm name) (county well located)

LANDOWNER: Dora McHarris
460 James Forrest Rd
Carriere Miss.
(mailing address)


description of formations encountered	from	to
<u>Red shale</u>	<u>0</u>	<u>20</u>
<u>Red sand</u>	<u>20</u>	<u>90</u>
<u>Blue shale</u>	<u>90</u>	<u>327</u>
<u>Grey sand</u>	<u>250</u>	<u>327</u>

WELL LOCATION:
sec 30 T 4 N R 17 E
S W
4 miles West of Carriere
(distance) (direction) (nearest town)

WELL PURPOSE: home
(home, irrigation, municipal, industrial)

WELL COMPLETION DATA:

- (1) diameter (inches) 4 1/2
- (2) total depth (feet) 327
- (3) static water level (feet) 134 below top of ground.
- (4) casing pvc 327
(material) (depth)
(size) if telescope see back.
- (5) screen 10 317
(length) (depth to top)
10 pvc
(size) (material)
- (6) pump 1 12
(HP) (yield gpm)
Elect
(type power)
- (7) electric log no
(yes or no)
(organization running log)
- (8) how well bottom plugged and
stuck

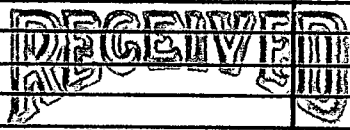


MAY 26 1992

Dept. of Environmental Quality
Bureau of Land & Water Resources

DRILLERS REMARKS:

If well telescopes please sketch and show depths.

GROUND LEVEL

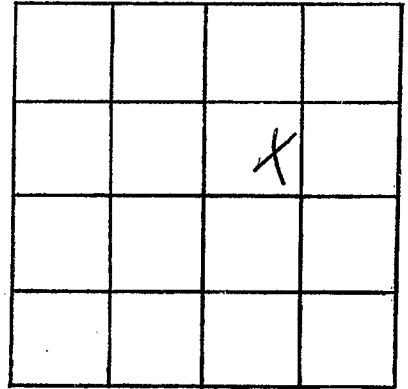

SECTION _____

Please indicate well location X.

ADDITIONAL INFORMATION

If more than one screen,
show locations of each on sketch.