

MISSISSIPPI DEPARTMENT OF NATURAL RESOURCES

Bureau of Land and Water Resources

Southport Mall

P.O. Box 10631

Jackson, Mississippi 39209

WATER WELL DRILLERS LOG

3/27
date well completed

92 Bud Thornton
firm name

pearl River
county well located

LANDOWNER: Mike
omsworth Carries
Love plantation Rd.
(mailing address)

description of formations encountered	from	to
<u>Red Shell</u>	<u>0</u>	<u>15</u>
<u>Red Sand</u>	<u>15</u>	<u>68</u>
<u>Blue Shell</u>	<u>68</u>	<u>150</u>
<u>Blue Sand</u>	<u>150</u>	<u>280</u>

WELL LOCATION:
sec. 29 T. 4 N R. 17 E
S W
7 miles West of Carries
(distance) (direction) (nearest town)

WELL PURPOSE:
(home, irrigation, municipal, industrial)

WELL COMPLETION DATA:

(1) diameter (inches) 2"

(2) total depth (feet) 280

(3) static water level (feet) 93 below above top of ground.

(4) casing pvc 280
(material) (depth)

(size) if telescope see back.

(5) screen 10 270
(length) (depth to top)

10 pvc
(size) (material)


(6) pump 1 350
(HP) (yield gpm)

Elect.
(type power)

(7) electric log no
(yes or no)

no
(organization running log)

(8) how well bottom plugged Sand
Sharp

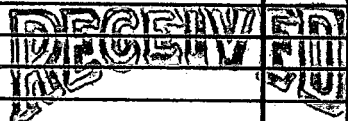


MAY 26 1992

Dept. of Environmental Quality
Bureau of Land & Water Resources

DRILLERS REMARKS:

If well telescopes please sketch and show depths.

GROUND LEVEL

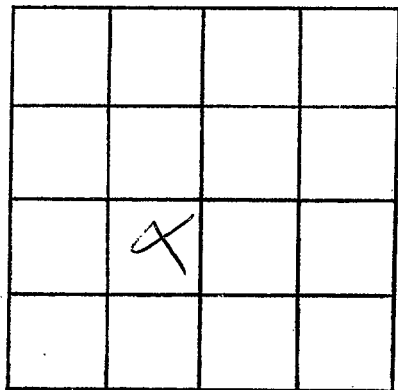

SECTION _____

Please indicate well location X.

ADDITIONAL INFORMATION

If more than one screen,
show locations of each on sketch.