

MISSISSIPPI DEPARTMENT OF NATURAL RESOURCES

Bureau of Land and Water Resources

Southport Mall

P.O. Box 10631

Jackson, Mississippi 39209

WATER WELL DRILLERS LOG

P. RIVER
P 219

9-1-1992 Bud Penton Water Well Pearl River
date well completed firm name county well located


LANDOWNER: Pearl Sones
Rt 1 Box 126 Carriere Ms
39426
(mailing address)

description of formations encountered	from	to
white shale	0	100
red sand	100	160
blue shale	160	180
white sand	180	215

WELL LOCATION:
sec 11 T 4 N R 17 E
S W
3 1/2 miles NW of Millcreek
(distance) (direction) (nearest town)

WELL PURPOSE: Home
(home, irrigation, municipal, industrial)

- WELL COMPLETION DATA:
- (1) diameter (inches) 5
 - (2) total depth (feet) 215
 - (3) static water level (feet) 57 (below/above top of ground)
 - (4) casing PVC, 205 (material) (depth)
2 (size) if telescope see back.
 - (5) screen 10, 205 (length) (depth to top)
2, PVC (size) (material)
 - (6) pump 1 (HP), 11 (yield gpm)
electric (type power)
 - (7) electric log NO (yes or no)
(organization running log)
 - (8) how well bottom plugged sandshark

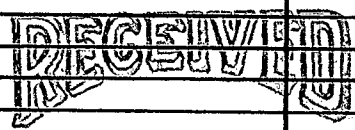


SEP 18 1992

Dept. of Environmental Quality
Bureau of Land & Water Resources

DRILLERS REMARKS:

If well telescopes please sketch and show depths.

GROUND LEVEL

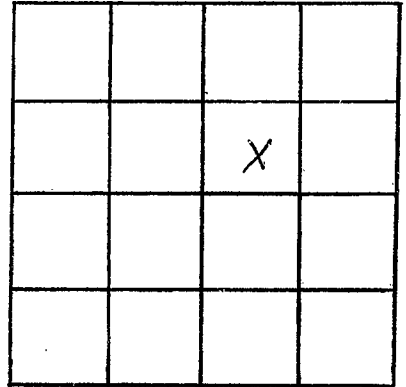

SECTION 11

Please indicate well location X.

ADDITIONAL INFORMATION

If more than one screen,
show locations of each on sketch.