

MISSISSIPPI DEPARTMENT OF NATURAL RESOURCES

Bureau of Land and Water Resources

Southport Mall

P.O. Box 10631

Jackson, Mississippi 39209

WATER WELL DRILLERS LOG

P. RIVER
P 2121

8-3-92 Bad Penton Water Well Pearl River
date well completed firm name county well located

LANDOWNER: Carl Jeansonne

description of formations encountered

from to

Rt 3 Virgil Lewis Rd.

Carriere Ms. 39426
(mailing address)

WELL LOCATION:


sec. 33 T 4 N R 17 E
S W
1.5 miles south of Millcreek
(distance) (direction) (nearest town)

White shale	0	18
White sand	18	30
Blue shale	30	168
White sand	168	189
Blue shale	189	430
Gray sand	430	567

WELL PURPOSE: Home
(home, irrigation, municipal, industrial)

WELL COMPLETION DATA:

- (1) diameter (inches) 5
- (2) total depth (feet) 567
- (3) static water level (feet) _____ below above top of ground.
- (4) casing PVC, 557
(material) (depth)
2 (size) if telescope see back.
- (5) screen 10' 557
(length) (depth to top)
2" PVC
(size) (material)
- (6) pump 1 11
(HP) (yield gpm)
electric
(type power)
- (7) electric log NO
(yes or no)

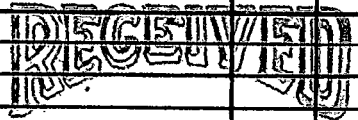

AUG 19 1992


(organization running log)
(8) how well bottom plugged sandshark

DRILLERS REMARKS:

Dept. of Environmental Quality
Bureau of Land & Water Resources

If well telescopes please sketch and show depths.

GROUND LEVEL

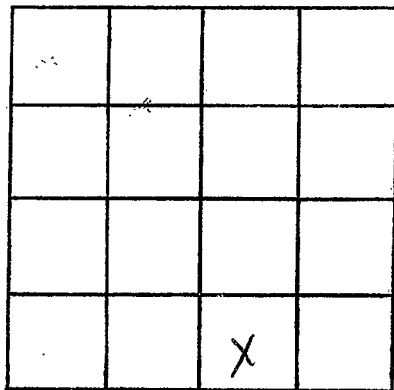

SECTION _____

Please indicate well location X.

ADDITIONAL INFORMATION

If more than one screen,
show locations of each on sketch.