

# MISSISSIPPI DEPARTMENT OF NATURAL RESOURCES

Bureau of Land and Water Resources

P.O. Box 10631  
Jackson, Mississippi 39209  
WATER WELL DRILLERS LOG

COUNTY WELL LOCATED <i>P.R.</i>	
WELL NUMBER <i>P</i>	CODED
<i>2127</i>	
DATE WELL COMPLETED <i>Aug 3-93</i>	

PERMIT NUMBER
NAME OF DRILLING FIRM <i>Walton Welding</i>

NAME & MAILING ADDRESS OF LANDOWNER <i>Don Griss</i>			
<i>Part 1 Carmin Mrs Bruc</i>			
<i>Twin Oaks Lane</i>			
WELL LOCATION:	SEC	TOWNSHIP	RANGE
	<i>20</i>	<i>4 S</i>	<i>17 W</i>
DISTANCE	DIRECTION	NEAREST TOWN	
<i>3</i> Miles	<i>NW</i>	<i>Monroe</i>	
OTHER LANDMARK <i>old Saw Transport Road</i>			
WELL PURPOSE: Home, Irrigation, Municipal, Industrial, Fish Pond, etc.			

PUMP DATA		
PUMP TYPE (Circle One): Submersible, Turbine, Jet, Flowing Well, Other (Describe) _____		
POWER TYPE (Circle One): <u>Electric</u> , Tractor, Diesel, Gasoline, Butane, Other (Describe) _____		
Pump Capacity (GPM)	No. of Stages	Setting Depth
	<i>2</i>	<i>90</i> FT.
PUMP TEST		
Well yielded <i>8</i> GPM with a drawdown of _____ ft. after _____ hours of pumping		

WELL DATA		
Well Depth <i>216'</i>	Casing Diameter (In.) <i>2"</i>	Casing Length (Ft.) <i>206</i>
Type of Casing <i>PVC</i>	Hole Depth <i>216'</i>	Depth to Static Water Level <i>76'</i>
TYPE OF COMPLETION: (Circle One or More): Gravel Packed, Underreamed, Telescoped, Natural Development, Open Hole, Other (Describe) <i>air</i>		
Top of Lap Pipe or Reduction in Casing		
FEET		IF TELESCOPED OR MORE THAN ONE SCREEN: USE BACK PAGE

LOG DATA	
TYPE OF LOG RUN (Circle One): No Log Run, Electric, Gamma Ray, Density, Sonic, Neutron, Other (Describe) _____	
Name of Organization Running Log	

SCREEN DATA		
Diameter - Inches <i>2"</i>	Length - Feet <i>10'</i>	Slot Size - Inches <i>10</i>
Screen Type	Depth to Bottom - Feet	


GEOLOGIC DATA (Office Use Only)			
Surface Elev.	Geologic Unit	Unit Thickness	Depth to Top
Subs. SWL	Date	Analysis	Aquifer Test
Driller's Remarks			

DESCRIPTION OF FORMATIONS ENCOUNTERED	FROM	TO	FORMATIONS (continued)	FROM	TO
<i>top soil</i>	<i>0</i>	<i>3</i>	<div style="font-size: 2em; opacity: 0.5; transform: rotate(-15deg); display: inline-block;">RECEIVED</div>  <div style="font-size: 1.5em; font-weight: bold;">SEP 09 1993</div>  <div style="text-align: center;">Dept. of Environmental Quality Office of Land &amp; Water Resources</div>		
<i>Red Clay</i>	<i>3</i>	<i>18</i>			
<i>Red sand</i>	<i>18</i>	<i>35</i>			
<i>white chalky</i>	<i>35</i>	<i>146</i>			
<i>Blue clay</i>	<i>146</i>	<i>180</i>			
<i>Sand Blk. pebb.</i>	<i>180</i>	<i>216</i>			

IF MORE SPACE IS NEEDED, USE BACK

If well telescopes please sketch and show depths.

GROUND LEVEL

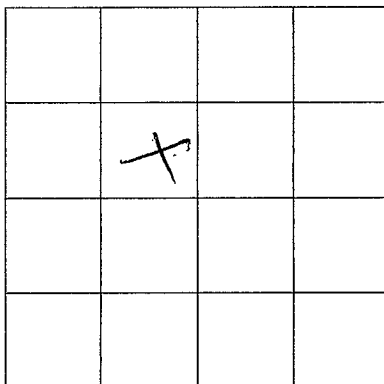

SECTION \_\_\_\_\_

Please indicate well location X.

ADDITIONAL INFORMATION

If more than one screen,  
show location of each on sketch.