

**MISSISSIPPI DEPARTMENT OF ENVIRONMENTAL QUALITY**

Office of Land and Water Resources

P. O. Box 10631  
Jackson, MS 39289-0631  
**WATER WELL DRILLERS LOG**

COUNTY WELL LOCATED <u>Pearl River</u>	
WELL NUMBER <u>2129</u>	CODED
DATE WELL COMPLETED <u>7-2-93</u>	

PERMIT NUMBER
NAME OF DRILLING FIRM <u>Bud Penton &amp; Son</u> <u>Water Well Service</u>

NAME & MAILING ADDRESS OF LANDOWNER <u>Charles Gianelloni</u>			
<u>313 LA Row Carriere</u>			
<u>Ms 39426</u>			
WELL LOCATION:	SEC	TOWNSHIP	RANGE
	<u>9</u>	<u>4</u> <sup>N</sup>	<u>17</u> <sup>E</sup>
DISTANCE	DIRECTION	NEAREST TOWN	
<u>3</u> Miles	<u>N</u>	of <u>Millcreek</u>	
OTHER LANDMARK			
WELL PURPOSE: Home, Irrigation, Municipal, Industrial, Fish Pond, etc. <u>Home</u>			

PUMP DATA		
PUMP TYPE (Circle One): Submersible, Turbine, <u>Jet</u> Flowing Well, Other (Describe) _____		
POWER TYPE (Circle One): <u>Electric</u> , Tractor, Diesel, Gasoline, Butane, Other (Describe) _____ H/P <u>1</u>		
Pump Capacity (GPM) <u>10</u>	No. of Stages <u>2</u>	Setting Depth <u>90</u> FT.
PUMP TEST		
Well yielded _____ GPM with a drawdown of _____ ft. after _____ hours of pumping		

WELL DATA		
Well Depth <u>175</u>	Casing Diameter (In.) <u>2</u>	Casing Length (Ft.) <u>165</u>
Type of Casing <u>PVC</u>	Hole Depth <u>175</u>	Depth to Static Water Level <u>80</u>
TYPE OF COMPLETION: (Circle One or More): <u>Gravel Packed</u> , <u>Natural Development</u> , Underreamed, Telescoped, Open Hole, Other		

LOG DATA	
TYPE OF LOG RUN (Circle One): Electric, Gamma Ray, Density, Sonic, <u>No Log Run</u> , Other (Describe) _____	
Name of Organization Running Log	

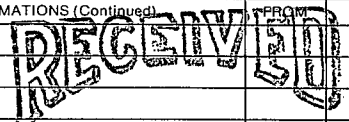
WELL GROUTED TO A DEPTH OF 10 FEET  
Type Grout (circle one): Cement, Bentonite, or Mix

GEOLOGIC DATA (Office Use Only)			
Surface Elev.	Geologic Unit	Unit Thickness	Depth to Top
Subs. SWL	Date	Analysis	Aquifer Test

SCREEN DATA		
Diameter - Inches <u>2</u>	Length - Feet <u>10</u>	Slot Size - Inches <u>.008</u>
Screen Type <u>PVC</u>	Depth to Bottom - Feet <u>175</u>	

Driller's Remarks

DESCRIPTION OF FORMATIONS ENCOUNTERED	FROM	TO
<u>white clay</u>	<u>0</u>	<u>84</u>
<u>white sand</u>	<u>84</u>	<u>105</u>
<u>blue clay</u>	<u>105</u>	<u>140</u>
<u>white sand</u>	<u>140</u>	<u>175</u>

FORMATIONS (Continued)	
 <b>SEP 20 1993</b>	
Dept. of Environmental Quality Office of Land & Water Resources	
IF MORE SPACE IS NEEDED, USE BACK	

If well telescopes please sketch and show depths.

GROUND LEVEL

		X	

SECTION 9

Please indicate well location X.

ADDITIONAL INFORMATION

If more than one screen,  
show location of each on sketch.