

MISSISSIPPI DEPARTMENT OF ENVIRONMENTAL QUALITY

Office of Land and Water Resources

P. O. Box 10631
Jackson, MS 39289-0631
WATER WELL DRILLERS LOG

COUNTY WELL LOCATED
Franklin Co.

WELL NUMBER
2134

CODED

DATE WELL COMPLETED
10-13-94

PERMIT NUMBER
0-519

NAME OF DRILLING FIRM
BURGE JACK

Drilling

NAME & MAILING ADDRESS OF LANDOWNER
DANA BOWEN

60 ROBERT WALKER RD

CARRIZO MS

WELL LOCATION: SEC TOWNSHIP RANGE
4 N 17 E

DISTANCE DIRECTION NEAREST TOWN
14 Miles NORTH of P. CAYNE

OTHER LANDMARK
ACROSS ROAD FROM BILLY WALKER

WELL PURPOSE: Home Irrigation, Municipal, Industrial, Fish Pond, etc.

PUMP DATA

PUMP TYPE (Circle One):
 Submersible, Turbine, Jet, Flowing Well,
Other (Describe) _____

POWER TYPE (Circle One):
 Electric, Tractor, Diesel, Gasoline, Butane,
Other (Describe) _____ H/P *1*

Pump Capacity (GPM) No. of Stages Setting Depth
15 14 80 FT.

PUMP TEST

Well yielded _____ GPM with
a drawdown of _____ ft.
after _____ hours of pumping

WELL DATA

Well Depth <i>85</i>	Casing Diameter (In.) <i>4</i>	Casing Length (Ft.) <i>65</i>
Type of Casing <i>PVC</i>	Hole Depth <i>86"</i>	Depth to Static Water Level <i>40"</i>

TYPE OF COMPLETION: (Circle One or More):
 Gravel Packed, Underreamed, Telescoped,
 Natural Development, Open Hole, Other

WELL GROUTED TO A DEPTH OF *10* FEET
Type Grout (circle one): Cement, Bentonite, or Mix

LOG DATA

TYPE OF LOG RUN (Circle One):
 No Log Run, Electric, Gamma Ray, Density, Sonic, Neutron,
Other (Describe) _____

Name of Organization Running Log

SCREEN DATA

Diameter - Inches <i>4</i>	Length - Feet <i>20</i>	Slot Size - Inches <i>#12</i>
Screen Type <i>SLOT</i>	Depth to Bottom - Feet <i>85"</i>	

GEOLOGIC DATA (Office Use Only)

Surface Elev.	Geologic Unit	Unit Thickness	Depth to Top
Subs. SWL	Date	Analysis	Aquifer Test

Driller's Remarks

Top of Lap Pipe or Reduction in Casing

FEET IF TELESKOPED OR MORE THAN ONE SCREEN: USE BACK PAGE

DESCRIPTION OF FORMATIONS ENCOUNTERED	FROM	TO	FORMATIONS (Continued)	FROM	TO
<i>RED DIRT</i>	<i>0</i>	<i>15</i>			
<i>RED SAND</i>	<i>15</i>	<i>35</i>			
<i>PURPLE CLAY</i>	<i>35</i>	<i>65</i>			
<i>SAND</i>	<i>65</i>	<i>85</i>			

RECEIVED


DEC 14 1994

Dept. of Environmental Quality
Office of Land & Water Resources

IF MORE SPACE IS NEEDED, USE BACK

If well telescopes please sketch and show depths.

GROUND LEVEL

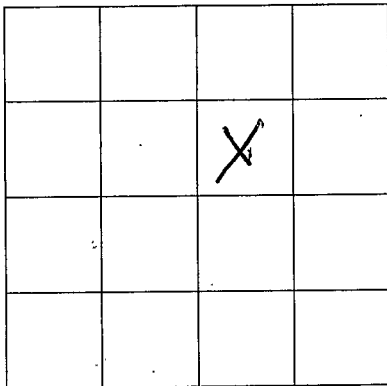

SECTION _____

Please indicate well location X.

ADDITIONAL INFORMATION

DRILLED ONE HOLE 208
+ PLUGGED

If more than one screen,
show location of each on sketch.