

**MISSISSIPPI DEPARTMENT OF ENVIRONMENTAL QUALITY**

Office of Land and Water Resources

P. O. Box 10631  
Jackson, MS 39289-0631

**WATER WELL DRILLERS LOG**

COUNTY WELL LOCATED  
**PEARL RIVER**

WELL NUMBER **P** CODED

**2136**

DATE WELL COMPLETED  
**11-8-74**

PERMIT NUMBER  
**0-519**

NAME OF DRILLING FIRM  
**BURGE WELL SERVICE**

NAME & MAILING ADDRESS OF LANDOWNER  
**CARL STOCK STILL**  
**QUITMAN PERRY RD.**  
**CARRIAGE MS.**

WELL LOCATION: SEC \_\_\_\_\_ TOWNSHIP \_\_\_\_\_ RANGE \_\_\_\_\_  
**4 N 8 12 E**

DISTANCE \_\_\_\_\_ DIRECTION \_\_\_\_\_ NEAREST TOWN \_\_\_\_\_  
**16 Miles NORTH of PERRY RD**

OTHER LANDMARK  
**PERRY R.D.**

WELL PURPOSE: Home Irrigation, Municipal, Industrial, Fish Pond, etc.

**PUMP DATA**

PUMP TYPE (Circle One):  
Submersible, Turbine, Jet, Flowing Well,  
Other (Describe) \_\_\_\_\_

POWER TYPE (Circle One):  
Electric, Tractor, Diesel, Gasoline, Butane,  
Other (Describe) \_\_\_\_\_ H/P 1

Pump Capacity (GPM) No. of Stages Setting Depth  
**20 10 200 FT.**

PUMP TEST  
Well yielded **20** GPM with  
a drawdown of \_\_\_\_\_ ft.  
after \_\_\_\_\_ hours of pumping

**WELL DATA**

Well Depth <b>212</b>	Casing Diameter (In.) <b>4</b>	Casing Length (Ft.) <b>212</b>
Type of Casing <b>PVC</b>	Hole Depth <b>212</b>	Depth to Static Water Level <b>110</b>

TYPE OF COMPLETION: (Circle One or More):  
Gravel Packed, Underreamed, Telescoped,  
Natural Development, Open Hole, Other  
(Describe) **PIPE**

WELL GROUTED TO A DEPTH OF **10** FEET  
Type Grout (circle one): Cement, Bentonite, or Mix

**LOG DATA**

TYPE OF LOG RUN (Circle One): No Log Run,  
Electric, Gamma Ray, Density, Sonic, Neutron,  
Other (Describe) \_\_\_\_\_

Name of Organization Running Log

**SCREEN DATA**

Diameter - Inches <b>4</b>	Length - Feet <b>20'</b>	Slot Size - Inches <b>#12</b>
Screen Type <b>SLOT</b>	Depth to Bottom - Feet <b>212</b>	

**GEOLOGIC DATA (Office Use Only)**

Surface Elev.	Geologic Unit	Unit Thickness	Depth to Top
Subs. SWL	Date	Analysis	Aquifer Test

Driller's Remarks

Top of Lap Pipe or Reduction in Casing


FEET IF TELESKOPED OR MORE THAN ONE SCREEN: USE BACK PAGE

DESCRIPTION OF FORMATIONS ENCOUNTERED	FROM	TO
<b>BLACK DIRT</b>	<b>0</b>	<b>10</b>
<b>RED CLAY</b>	<b>10</b>	<b>40</b>
<b>SAND</b>	<b>40</b>	<b>80</b>
<b>WHITE CLAY</b>	<b>80</b>	<b>120</b>
<b>BLUE CLAY</b>	<b>120</b>	<b>180</b>
<b>SAND</b>	<b>180</b>	<b>212</b>

FORMATIONS (Continued)	FROM	TO
<b>RECEIVED</b>		
<b>DEC 14 1994</b>		
Dept. of Environmental Quality Office of Land & Water Resources		
IF MORE SPACE IS NEEDED, USE BACK		

If well telescopes please sketch and show depths.

GROUND LEVEL

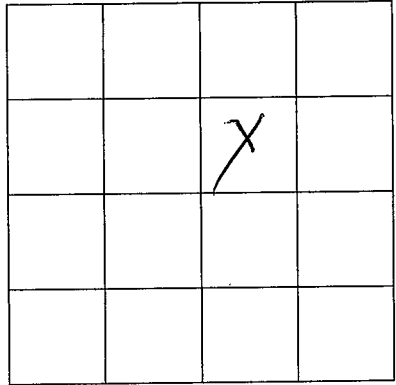

SECTION \_\_\_\_\_

Please indicate well location X.

ADDITIONAL INFORMATION

If more than one screen,  
show location of each on sketch.