

MISSISSIPPI DEPARTMENT OF ENVIRONMENTAL QUALITY

Office of Land and Water Resources

P. O. Box 10631
Jackson, MS 39289-0631
WATER WELL DRILLERS LOG

COUNTY WELL LOCATED <i>Pearl River</i>	
WELL NUMBER <i>798-6485</i>	CODED
P 213A	
DATE WELL COMPLETED <i>5-3-95</i>	

PERMIT NUMBER <i>0-477</i>
NAME OF DRILLING FIRM <i>PENTON WELL</i>
<i>Nicholson, MS.</i>

NAME & MAILING ADDRESS OF LANDOWNER <i>David Suttora</i>			
<i>SUTTORA LANE</i>			
<i>Carriere, MS. 39426</i>			
WELL LOCATION:	SEC	TOWNSHIP	RANGE
	<i>29</i>	<i>4</i>	<i>17</i>
		<i>S</i>	<i>W</i>
DISTANCE	DIRECTION	NEAREST TOWN	
<i>1</i>	<i>W</i>	<i>Midick</i>	
OTHER LANDMARK			
WELL PURPOSE: Home, Irrigation, Municipal, Industrial, Fish Pond, etc. <i>Home</i>			

PUMP DATA		
PUMP TYPE (Circle One): Submersible, Turbine, Jet, Flowing Well, Other (Describe) _____		
POWER TYPE (Circle One): <u>Electric</u> , Tractor, Diesel, Gasoline, Butane, Other (Describe) _____ H/P _____		
Pump Capacity (GPM)	No. of Stages	Setting Depth
	<i>9</i>	<i>95</i> FT.
PUMP TEST		
Well yielded _____ GPM with a drawdown of _____ ft. after _____ hours of pumping		

WELL DATA		
Well Depth <i>515</i>	Casing Diameter (In.) <i>4x2</i>	Casing Length (Ft.) <i>505</i>
Type of Casing <i>PVC</i>	Hole Depth <i>515</i>	Depth to Static Water Level <i>66</i>
TYPE OF COMPLETION: (Circle One or More): Gravel Packed, Underreamed, Telescoped, <u>Natural Development</u> , Open Hole, Other (Describe) _____		

LOG DATA	
TYPE OF LOG RUN (Circle One): Electric, Gamma Ray, Density, Sonic, Neutron, Other (Describe) _____ <u>No Log Run</u>	
Name of Organization Running Log	

WELL GROUTED TO A DEPTH OF <i>10</i> FEET Type Grout (circle one): <u>Cement</u> , Bentonite, or Mix

GEOLOGIC DATA (Office Use Only)			
Surface Elev.	Geologic Unit	Unit Thickness	Depth to Top
Subs. SWL	Date	Analysis	Aquifer Test

SCREEN DATA		
Diameter - Inches <i>2</i>	Length - Feet <i>10</i>	Slot Size - Inches <i>10-12</i>
Screen Type <i>PVC</i>	Depth to Bottom - Feet <i>515</i>	

Driller's Remarks

DESCRIPTION OF FORMATIONS ENCOUNTERED	FROM	TO
<i>CLAY</i>	<i>0</i>	<i>245</i>
<i>SAND</i>	<i>245</i>	<i>290</i>
<i>CLAY</i>	<i>290</i>	<i>370</i>
<i>SAND</i>	<i>370</i>	<i>410</i>
<i>CLAY</i>	<i>410</i>	<i>440</i>
<i>SAND</i>	<i>440</i>	<i>515</i>

FORMATIONS (Continued)	FROM	TO

RECEIVED


MAY 08 1995

Dept. of Environmental Quality
Office of Land & Water Resources

IF MORE SPACE IS NEEDED, USE BACK

If well telescopes please sketch and show depths.

GROUND LEVEL

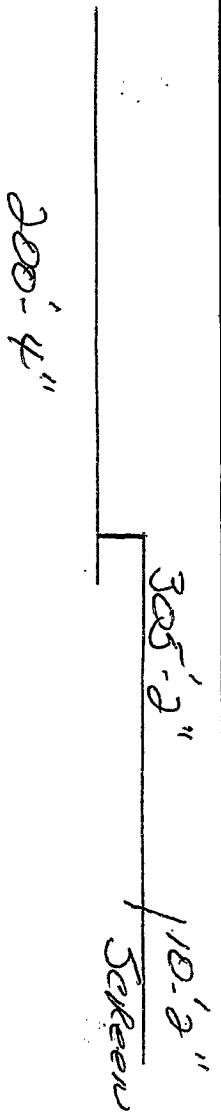

	X		

SECTION 29

Please indicate well location X.

ADDITIONAL INFORMATION

If more than one screen, show location of each on sketch.