

# MISSISSIPPI DEPARTMENT OF NATURAL RESOURCES

Bureau of Land and Water Resources

P.O. Box 10631

Jackson, Mississippi 39209

## WATER WELL DRILLERS LOG

COUNTY WELL LOCATED	
<i>Pearl River</i>	
WELL NUMBER	CODED
<i>P</i>	
<i>2141</i>	
DATE WELL COMPLETED	
<i>8-29-95</i>	

PERMIT NUMBER
NAME OF DRILLING FIRM
<i>Walkers Well Service</i>

NAME & MAILING ADDRESS OF LANDOWNER			
<i>C. Dandridge</i>			
<i>65 Sattoria Lane</i>			
<i>Carrriere, Miss</i>			
WELL LOCATION:	SEC	TOWNSHIP	RANGE
	<i>29</i>	<i>4</i>	<i>N 17 E</i>
DISTANCE	DIRECTION	NEAREST TOWN	
<i>2-3</i> Miles	<i>SE</i>	<i>Henleyfield</i>	
OTHER LANDMARK			
WELL PURPOSE: Home, Irrigation, Municipal, Industrial, Fish Pond, etc.			
<i>Home</i>			

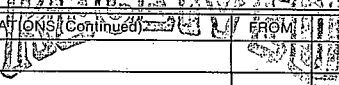
PUMP DATA		
PUMP TYPE (Circle One):		
Submersible,	Turbine,	Jet
Other (Describe) _____		
POWER TYPE (Circle One):		
Electric,	Tractor,	Diesel,
Gasoline,	Butane,	
Other (Describe) _____		
Pump Capacity (GPM)	No. of Stages	Setting Depth
		FT.
PUMP TEST		
Well yielded _____ GPM with		
a drawdown of _____ ft.		
after _____ hours of pumping		

WELL DATA		
Well Depth	Casing Diameter (In.)	Casing Length (Ft.)
<i>80'</i>	<i>2"</i>	<i>70'</i>
Type of Casing	Hole Depth	Depth to Static Water Level
<i>PVC</i>	<i>80'</i>	<i>34'</i>
TYPE OF COMPLETION: (Circle One or More):		
<input checked="" type="checkbox"/> Gravel Packed,	<input type="checkbox"/> Underreamed,	<input type="checkbox"/> Telescoped,
<input checked="" type="checkbox"/> Natural Development,	<input type="checkbox"/> Open Hole,	<input type="checkbox"/> Other
(Describe) _____		
Top of Lap Pipe or Reduction in Casing		
FEET	IF TELESCOPED OR MORE THAN ONE SCREEN: USE BACK PAGE	

LOG DATA	
TYPE OF LOG RUN (Circle One):	
Electric,	Gamma Ray,
Density,	Sonic,
Neutron,	No Log Run,
Other (Describe) _____	
Name of Organization Running Log	

SCREEN DATA		
Diameter - Inches	Length - Feet	Slot Size - Inches
<i>2"</i>	<i>10'</i>	<i>10/10</i>
Screen Type	Depth to Bottom - Feet	
<i>PVC</i>	<i>80'</i>	

GEOLOGIC DATA (Office Use Only)			
Surface Elev.	Geologic Unit	Unit Thickness	Depth to Top
Subs. SWL	Date	Analysis	Aquifer Test
Driller's Remarks			

DESCRIPTION OF FORMATIONS ENCOUNTERED	FROM	TO	FORMATION(S) (Continued) FROM TO
<i>Red Clay</i>	<i>0</i>	<i>18'</i>	<div style="text-align: center;">   <b>NOV 06 1995</b>                      Dept. of Environmental Quality                      Office of Land &amp; Water Resources                 </div>
<i>Red Sand</i>	<i>18'</i>	<i>36'</i>	
<i>Sand &amp; Gravel</i>	<i>36'</i>	<i>80'</i>	
<i>Bottom of well</i>			

IF MORE SPACE IS NEEDED, USE BACK

If well telescopes please sketch and show depths.

GROUND LEVEL

	X		

SECTION \_\_\_\_\_

Please indicate well location X.

ADDITIONAL INFORMATION

If more than one screen,  
show location of each on sketch.