

**MISSISSIPPI DEPARTMENT OF NATURAL RESOURCES**  
Bureau of Land and Water Resources

P.O. Box 10631

Jackson, Mississippi 39209

**WATER WELL DRILLERS LOG**

COUNTY WELL LOCATED  
*Pearl River*

WELL NUMBER  
*P 2149*

CODED

DATE WELL COMPLETED  
*9-26-94*

PERMIT NUMBER

NAME OF DRILLING FIRM  
*Walker Welding & Repair*

NAME & MAILING ADDRESS OF LANDOWNER  
*Glenn Alfonso*

*Riley Boone Road*

*Carrico, Miss 39426*

WELL LOCATION: SEC TOWNSHIP RANGE  
*29 4 N 17 E*

DISTANCE DIRECTION NEAREST TOWN  
*12* Miles *N* of *Picayune*

OTHER LANDMARK

WELL PURPOSE:  Home Irrigation,  Municipal,  Industrial,  Fish Pond, etc.

**PUMP DATA**

PUMP TYPE (Circle One):  
 Submersible,  Turbine,  Jet,  Flowing Well,  
Other (Describe) \_\_\_\_\_

POWER TYPE (Circle One):  
 Electric,  Tractor,  Diesel,  Gasoline,  Butane,  
Other (Describe) \_\_\_\_\_

Pump Capacity (GPM) No. of Stages Setting Depth  
*10* *110'* FT.

PUMP TEST

Well yielded \_\_\_\_\_ GPM with  
a drawdown of \_\_\_\_\_ ft.  
after \_\_\_\_\_ hours of pumping

**WELL DATA**

Well Depth <i>252'</i>	Casing Diameter (In.) <i>4"</i>	Casing Length (Ft.) <i>232'</i>
Type of Casing <i>PVC</i>	Hole Depth <i>252'</i>	Depth to Static Water Level <i>70'</i>

TYPE OF COMPLETION: (Circle One or More):  
 Gravel Packed,  Underreamed,  Telescoped,  
 Natural Development,  Open Hole,  Other  
(Describe) \_\_\_\_\_

Top of Lap Pipe or Reduction in Casing  
FEET  IF TELESCOPED OR MORE THAN ONE SCREEN: USE BACK PAGE

**LOG DATA**

TYPE OF LOG RUN (Circle One):  
 No Log Run,  Electric,  Gamma Ray,  Density,  Sonic,  Neutron,  
Other (Describe) \_\_\_\_\_

Name of Organization Running Log

**SCREEN DATA**

Diameter - Inches <i>2"</i>	Length - Feet <i>20'</i>	Slot Size - Inches <i>.010</i>
Screen Type <i>PVC</i>	Depth to Bottom - Feet <i>252'</i>	

**GEOLOGIC DATA (Office Use Only)**

Surface Elev.	Geologic Unit	Unit Thickness	Depth to Top
Subs. SWL	Date	Analysis	Aquifer Test

Driller's Remarks

DESCRIPTION OF FORMATIONS ENCOUNTERED	FROM	TO	FORMATIONS (Continued)	FROM	TO
<i>Top Soil &amp; Red Sandy Clay</i>	<i>0</i>	<i>30'</i>			
<i>Blue Clay</i>	<i>30'</i>	<i>198'</i>			
<i>Coarse Sand &amp; Blue Rock</i>	<i>198'</i>	<i>252'</i>			



**RECEIVED**  
**OCT 07 1994**

Dept. of Environmental Quality  
Office of Land & Water Resources

IF MORE SPACE IS NEEDED, USE BACK

If well telescopes please sketch and show depths.

GROUND LEVEL

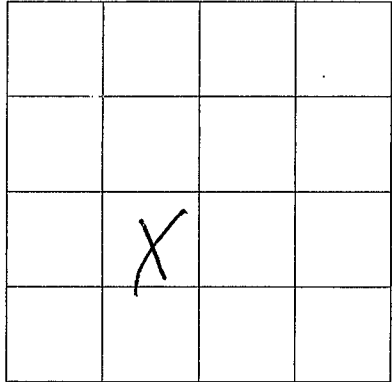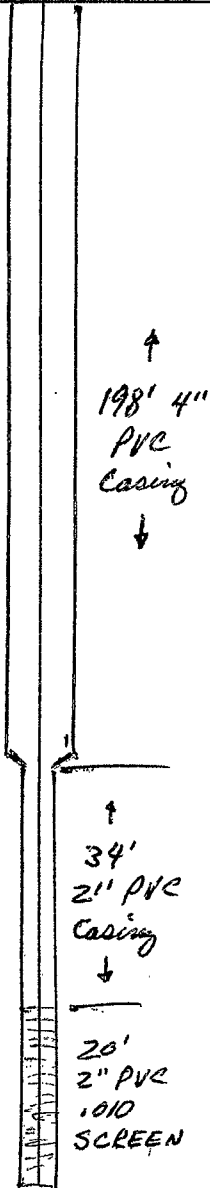

SECTION 29

Please indicate well location X.

ADDITIONAL INFORMATION

If more than one screen, show location of each on sketch.