

MISSISSIPPI DEPARTMENT OF NATURAL RESOURCES

Bureau of Land and Water Resources

P.O. Box 10631

Jackson, Mississippi 39209

WATER WELL DRILLERS LOG

COUNTY WELL LOCATED <i>Pearl River</i>	
WELL NUMBER <i>P 2156</i>	CODED
DATE WELL COMPLETED <i>8-14-77</i>	

PERMIT NUMBER
NAME OF DRILLING FIRM <i>Walkers Well Drilling</i>

NAME & MAILING ADDRESS OF LANDOWNER <i>Jim Faircloth</i>			
WELL LOCATION:	SEC	TOWNSHIP	RANGE
	<i>17</i>	<i>4</i>	<i>N 17 E</i>
DISTANCE	DIRECTION	NEAREST TOWN	
<i>14</i> Miles	<i>N</i>	of <i>Picayune</i>	
OTHER LANDMARK			
WELL PURPOSE: <i>Home Irrigation</i> , Municipal, Industrial, Fish Pond, etc.			

PUMP DATA		
PUMP TYPE (Circle One): <input checked="" type="radio"/> Submersible, Turbine, Jet, Flowing Well, Other (Describe) _____		
POWER TYPE (Circle One): <input checked="" type="radio"/> Electric, Tractor, Diesel, Gasoline, Butane, Other (Describe) _____		
Pump Capacity (GPM) <i>10</i>	No. of Stages	Setting Depth <i>60'</i> FT.
PUMP TEST		
Well yielded _____ GPM with a drawdown of _____ ft. after _____ hours of pumping		

WELL DATA		
Well Depth <i>80'</i>	Casing Diameter (In.) <i>4"</i>	Casing Length (Ft.) <i>70'</i>
Type of Casing <i>PVC</i>	Hole Depth <i>80'</i>	Depth to Static Water Level <i>45'</i>
TYPE OF COMPLETION: (Circle One or More): <input checked="" type="radio"/> Gravel Packed, Underreamed, Telescoped, Natural Development, Open Hole, Other (Describe) _____		
Top of Lap Pipe or Reduction in Casing FEET <input type="checkbox"/> IF TELESCOPED OR MORE THAN ONE SCREEN: USE BACK PAGE		

LOG DATA	
TYPE OF LOG RUN (Circle One): <input type="radio"/> No Log Run, Electric, Gamma Ray, Density, Sonic, Neutron, Other (Describe) _____	
Name of Organization Running Log	

SCREEN DATA		
Diameter - Inches <i>4"</i>	Length - Feet <i>10</i>	Slot Size - Inches <i>.010</i>
Screen Type <i>PVC</i>	Depth to Bottom - Feet <i>.80'</i>	

GEOLOGIC DATA (Office Use Only)			
Surface Elev.	Geologic Unit	Unit Thickness	Depth to Top
Subs. SWL	Date	Analysis	Aquifer Test


Driller's Remarks

DESCRIPTION OF FORMATIONS ENCOUNTERED	FROM	TO	FORMATIONS (continued)	FROM	TO
<i>Red Top Soil</i>	<i>0</i>	<i>18</i>	<div style="border: 2px solid black; padding: 5px; display: inline-block;"> RECEIVED AUG 25 1997 </div>		
<i>Blue Clay</i>	<i>18</i>	<i>60</i>			
<i>Sandy Gravel & Coarse Sand</i>	<i>60</i>	<i>80</i>			
			Dept. of Environmental Quality Office of Land & Water Resources		

IF MORE SPACE IS NEEDED, USE BACK

If well telescopes please
sketch and show depths.

GROUND LEVEL

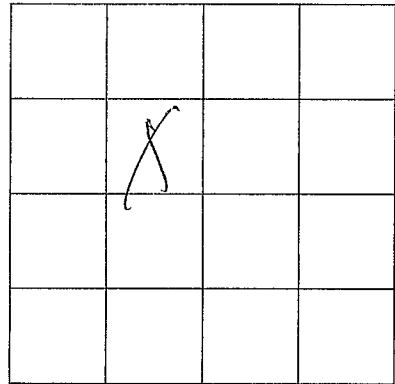

SECTION _____

Please indicate well location X.

ADDITIONAL INFORMATION

If more than one screen,
show location of each on sketch.