

MISSISSIPPI DEPARTMENT OF ENVIRONMENTAL QUALITY
Office of Land and Water Resources

P. O. Box 10631
Jackson, MS 39289-0631
WATER WELL DRILLERS LOG

COUNTY WELL LOCATED
Pearl River

WELL NUMBER CODED
R-2168

DATE WELL COMPLETED
7-28-2000

PERMIT NUMBER

NAME OF DRILLING FIRM
Boones Water Well

NAME & MAILING ADDRESS OF LANDOWNER
Lois Seward

472 Harry Sones Rd

Prayune, ms 39466

WELL LOCATION: SEC 23 TOWNSHIP 4 RANGE 17 S E

DISTANCE 6 Miles DIRECTION W of NEAREST TOWN McNeil

OTHER LANDMARK

WELL PURPOSE: Irrigation, Municipal, Industrial, Fish Pond, etc.

PUMP DATA

PUMP TYPE (Circle One):
 Submersible Turbine, Jet Flowing Well,
Other (Describe) _____

POWER TYPE (Circle One):
 Electric, Tractor, Diesel, Gasoline, Butane,
Other (Describe) _____ H/P 2

Pump Capacity (GPM) 50 No. of Stages _____ Setting Depth _____ FT.

PUMP TEST

Well yielded _____ GPM with
a drawdown of _____ ft.
after _____ hours of pumping

WELL DATA

Well Depth 155 Casing Diameter (In.) 4 Casing Length (Ft.) 135

Type of Casing Sch 40 Hole Depth 155 Depth to Static Water Level 50

LOG DATA

TYPE OF LOG RUN (Circle One): No Log Run, Electric, Gamma Ray, Density, Sonic, Neutron, Other (Describe) _____

Name of Organization Running Log

TYPE OF COMPLETION: (Circle One or More):
 Gravel Packed, Underreamed, Telescoped,
Natural Development, Open Hole, Other

WELL GROUTED TO A DEPTH OF 10 FEET
Type Grout (circle one): Cement, Bentonite, or Mix

GEOLOGIC DATA (Office Use Only)

Surface Elev.	Geologic Unit	Unit Thickness	Depth to Top
Subs. SWL	Date	Analysis	Aquifer Test

Driller's Remarks

Top of Lap Pipe or Reduction in Casing

IF TELESCOPED OR MORE THAN ONE SCREEN, USE BACK PAGE

SCREEN DATA

Diameter - Inches 4 Length - Feet 20 Slot Size - Inches #8

Screen Type Sch 40 Depth to Bottom - Feet

DESCRIPTION OF FORMATIONS ENCOUNTERED	FROM	TO
<u>clay</u>	<u>0</u>	<u>90</u>
<u>sand</u>	<u>90</u>	<u>135</u>

FORMATIONS (Continued)

FROM TO


SEP 07 2000

Dept. of Environmental Quality
Office of Land & Water Resources

IF MORE SPACE IS NEEDED, USE BACK

If well telescopes please
sketch and show depths.

GROUND LEVEL

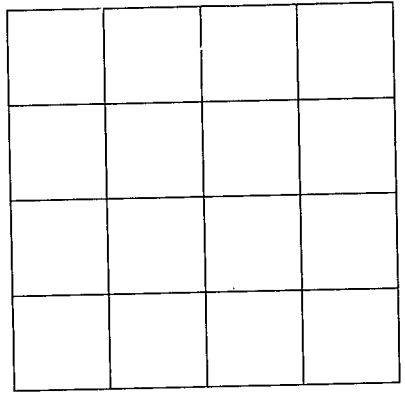

SECTION _____

Please indicate well location X.

ADDITIONAL INFORMATION

If more than one screen,
show location of each on sketch.