

CODED

Pearl River  
Q2  
2-14-69

MISSISSIPPI  
BOARD OF WATER COMMISSIONERS  
416 North State Street  
Jackson, Mississippi 39201

CODED

WATER WELL DRILLERS LOG

2-14 1969 Penton Well Serv Pearl River  
date well completed firm name county well located

LANDOWNER: Buck Colman

description of formations encountered

from

to

McNeill Miss  
(mailing address)

Red Clay

0 18

sand

18 55

white clay

55 135

sand

135 145

Blue Clay

145 237

Grey sand

237 258

Blue Clay

258 357

Grey sand

357 404

WELL LOCATION:

sec. 20 T 4 S R. 16 W  
1 miles North of McNeill  
(distance) (direction) (nearest town)

WELL PURPOSE: Home  
(home, irrigation, municipal, industrial)

WELL COMPLETION DATA: 4 1/2

- (1) diameter (inches) 2"
- (2) total depth (feet) 404
- (3) static water level (feet) 103' below top of ground.

(4) casing Galv., 399'  
(material) (depth)

2"  
(size) If telescope see back.

(5) screen 5', 399'  
(length) (depth to top)

2"  
(size) (material)

(6) pump 1, 6  
(HP) (yield gpm)

Elec  
(type power)

(7) electric log NO  
(yes or no)

(organization running log)

(8) how well bottom plugged BW Valve


DRILLERS REMARKS:

FEB 25 1969

Miss. Bd. of  
Water Comm.

If well telescopes please sketch and show depths.

GROUND LEVEL

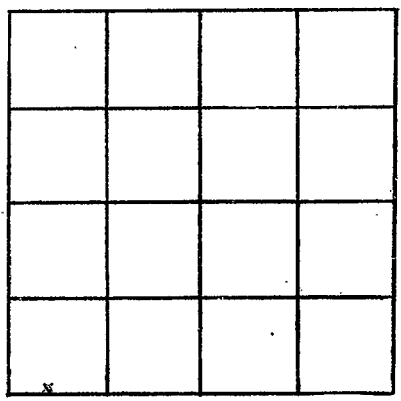

SECTION 20

Please indicate well location X.

ADDITIONAL INFORMATION

If more than one screen, show locations of each on sketch.