

PEARL RIVER

Q9

3-29-71

MISSISSIPPI BOARD OF WATER COMMISSIONERS
416 North State Street
Jackson, Mississippi 39201

CODED

WATER WELL DRILLERS LOG

3-29 1971 Ed J. W. Porter Well Serv. Pearl River
date well completed firm name county well located

LANDOWNER:
Steven Delaney
McNeil Miss.
(mailing address)

description of formations encountered from to
Red Clay 0 16
white coarse
silt. & gravel 16 36

WELL LOCATION:
sec 35 T 4 N R 16 E
2 miles East of McNeil
(distance) (direction) (nearest town)

WELL PURPOSE: Home
(home, irrigation, municipal, industrial)

WELL COMPLETION DATA:
(1) diameter (inches) 4.5
(2) total depth (feet) 36
(3) static water level (feet) 20 below top of ground
(4) casing Plastic 31' (material) (depth)
3" If telescope see back. (size)
(5) screen 5 31-36 (length) (depth to top)
2" Plastic (size) (material)
(6) pump 1/2 400 Hr. (HP) (yield gpm)
Elect (type power)
(7) electric log NO (yes or no)
(organization running log)
(8) how well bottom plugged shoe

CODED


MAY 17 1971

MISS. RD. OF WATER COM.

DRILLERS REMARKS:

If well telescopes please sketch and show depths.

GROUND LEVEL

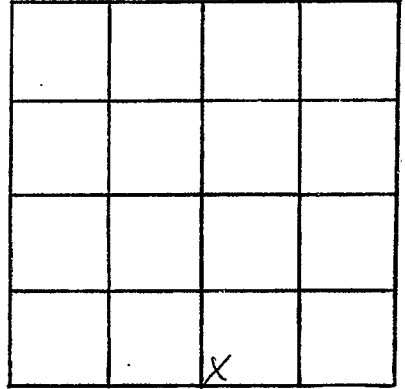

SECTION 35

Please indicate well location X.

ADDITIONAL INFORMATION

If more than one screen, show locations of each on sketch.