

Pearl R,

Q-12

9-2-60

WATER WELL DRILLERS LOG

Q-300

Date: 9-2, 1960, Driller: Quick & Grace

1370-19
960-1

(Name)

CODED

(1) Owner of Land: Robert Spiers

(Name)

McNeil Miss
TOWN

(Address)

(2) Location: 1/4, 1/4, Sec. 30 & 16

in town of _____
(distance) (direction) (Nearest Town)

(3) Topography: (hilly) (Flat) (Level)

(4) Purpose of Well: Domestic
(Domestic Irrigation
Municipal, Industrial, Other)

Description & Color of Materials Sand, Clay, Red Clay, Shell, etc.	Thick- ness Feet	Depth Feet
<u>Surface Sand</u>	<u>0</u>	<u>8.5</u>
<u>Blue + White Clay</u>	<u>8.5</u>	<u>270</u>
<u>Fine Sand</u>	<u>270</u>	<u>290</u>
<u>Blue Clay</u>	<u>290</u>	<u>300</u>
<u>Grey Sand</u>	<u>300</u>	<u>328</u>

Information upon completion of well:

(1) Diameter 2 inches.

(2) Total Depth 328 feet.

(3) Water Level 125 feet below top of ground.

(4) Cased to _____, Size _____

(5) Screen: Size 2", Length 5'

(6) Were any formations sealed against pollution?


_____ yes, no.

If YES depth of formation _____

Why _____

Drillers Remarks: Good well.

CODED

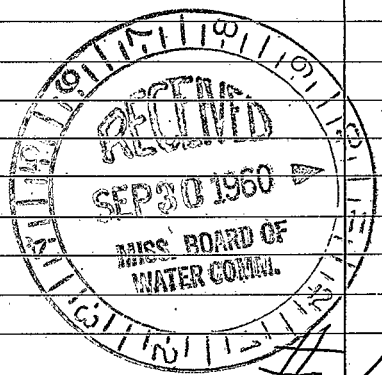

13

(Use Back Side)

Well No.

