

~~XXXXXXXXXX~~

Q-14

WATER WELL DRILLERS LOG

11-8-62

Date: Nov 8, 1962, Driller: Poupart
9129 (Name)

CODED Pearl River County

(1) Owner of Land: PAT BRADY,
(Name)
McNEILL MISS
(Address)

(2) Location: 1/4, 1/4, Sec. 31 T. 9 R. 16
1/4 miles South of McNeill
(distance) (direction) (Nearest Town)

(3) Topography: (Hilly) (Flat) (Level)

(4) Purpose of Well: Domestic
(Domestic Irrigation, Municipal, Industrial, Other)

Description & Color of Materials Sand, Clay, Red Clay, Shell, etc.	Thick- ness Feet	Depth Feet
0-2 5 Red Clay	25	25
SAND	10	
Clay, white	40	75
white SAND	15	115
Red Clay		
Red Clay	70	190
white SAND	30	220
Blue Clay	240	460
Blue SAND	30	492

Information upon completion of well:

(1) Diameter 2 inches.

(2) Total Depth 492 feet.

(3) Water Level 111 feet below top of ground.

(4) Cased to: _____, Size _____

(5) Screen: Size 008, Length 10'


(6) Were any formations sealed against pollution?
_____ yes, _____ no.

If YES depth of formation _____

Why _____

Drillers Remarks:
Good course
SAND

CODED

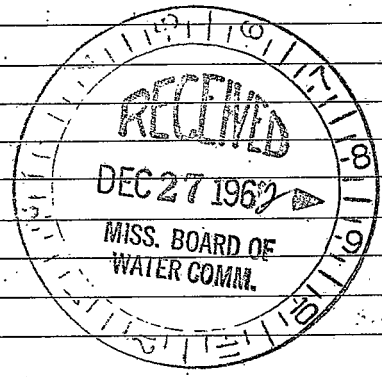

(Use Back Side)

Well No.

