

Q-15

11-15-62


WATER WELL DRILLERS LOG

Date: Nov 15, 1962, Driller: POUPART
(Name)

CODED PEARL RIVER

(1) Owner of Land:	Description & Color of Materials Sand, Clay, Red Clay, Shell, etc.	Thick- ness Feet	Depth Feet
<u>James Spear</u> (Name)	<u>Red Clay</u>	<u>18'</u>	
<u>McNeill Miss</u> (Address)	<u>SAND</u>	<u>25</u>	<u>43</u>
(2) Location: <u>1/4</u> , <u>1/4</u> , Sec. <u>33 T4 R16</u>	<u>Wht. Clay</u>	<u>20</u>	<u>63</u>
<u>4</u> miles <u>East</u> , of <u>McNeill</u>	<u>Blue Clay</u>	<u>57</u>	<u>120</u>
(distance) (direction) (Nearest Town)	<u>SAND</u>	<u>15</u>	<u>135</u>
(3) Topography: <input checked="" type="checkbox"/> (Hilly) (Flat) (Level)			
(4) Purpose of Well: (Domestic Irrigation Municipal, Industrial, Other)			
Information upon completion of well:			
(1) Diameter <u>2</u> inches.			
(2) Total Depth <u>135</u> feet.			
(3) Water Level <u>69</u> feet below top of ground.			
(4) Cased to _____, Size _____			
(5) Screen: Size <u>008</u> , Length <u>5'</u>			
(6) Were any formations sealed against pollution? _____ yes, _____ no.			
If YES depth of formation _____			
Why _____			
Drillers Remarks: _____			

CODED

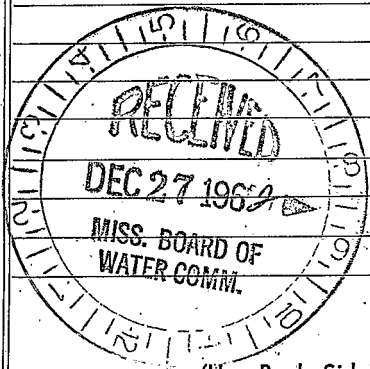

(Use Back Side)

Well No.

[The page contains extremely faint and illegible text, likely bleed-through from the reverse side of the document. No specific words or phrases can be discerned.]