

Pearl R.

MISSISSIPPI BOARD OF WATER COMMISSIONERS

Q-17

10-2-65

WATER WELL DRILLERS LOG

Date: 10-2, 1965, Driller: Neil Lumpkin, COLORED, (Name)

(1) Owner of Land: James Spiers (Name)
 McNeill (Address)
 (2) Location: 1/4, 1/4, Sec. 33, T. 4 R. 16, S. 1
 4 miles East of McNeill, (distance) (direction) (Nearest Town)
 (3) Topography: Flat (Hilly) (Flat) (Level)
 (4) Purpose of Well: Domestic (Domestic Irrigation, Municipal, Industrial, Other)


| Description & Color of Materials Sand, Clay, Red Clay, Shell, etc. | Thick-ness Feet | Depth Feet |
|---|-----------------|------------|
| Surface Clay | 0 | 10 |
| " sand | 10 | 60 |
| Blue clay | 60 | 210 |
| good grey sand | 210 | 273 |

Information upon completion of well:

(1) Diameter 2 inches.
 (2) Total Depth 273 feet.
 (3) Water Level 65 feet below top of ground.
 (4) Cased to _____, Size _____
 (5) Screen: Size 2", Length 5'
 (6) Were any formations sealed against pollution?
 _____ yes, No. no.

CODED

If YES depth of formation _____
 Why _____
 Drillers Remarks: _____

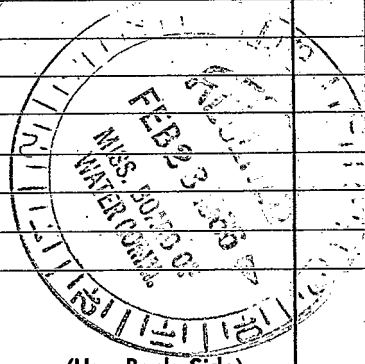

(Use Back Side)

Well No.

[The page contains extremely faint and illegible text, likely bleed-through from the reverse side of the document. The text is too light to transcribe accurately.]