

CODED

MISSISSIPPI
BOARD OF WATER COMMISSIONERS
416 North State Street
Jackson, Mississippi 39201

CODED

PEARL RIVER

Q-20

6-3-71

WATER WELL DRILLERS LOG

6-3 1971 Earl Pantan Water Pearl River
 date well completed firm name well serv. county well located

LANDOWNER:
Mr. J.W. Lewis
McNeil MISS.
 (mailing address)

WELL LOCATION:
 sec. 35 T 4 N R 16 E
3 miles East of McNeil
 (distance) (direction) (nearest town)

WELL PURPOSE: Home
 (home, irrigation, municipal, industrial)

WELL COMPLETION DATA:

(1) diameter (inches) 4 5/8

(2) total depth (feet) 174

(3) static water level (feet) 123 below top of ground.

(4) casing Galv. 169
 (material) (depth)
2" if telescope see back.
 (size)

(5) screen 5' 169-174
 (length) (depth to top)
2" S.S.
 (size) (material)

(6) pump 1 400
 (HP) (yield gpm)
Elect
 (type power)

(7) electric log NO
 (yes or no)
 (organization running log)

(8) how well bottom plugged sluc

description of formations encountered	from	to
Red Clay	0	5
Red Clay sh. sd.	5	15
White Clay	15	35
Red sd. & Red clay	35	68
White Clay II	68	72
Blue Clay	72	148
Coarse Gray sd.	148	174

CODED


AUG 24 1971

MISS. DE. OF WATER COMM.

DRILLERS REMARKS:

If well telescopes please sketch and show depths.

GROUND LEVEL

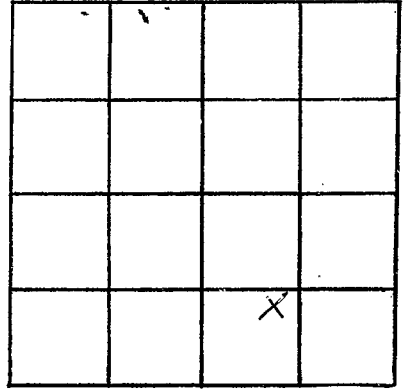

SECTION 35

Please indicate well location X.

ADDITIONAL INFORMATION

If more than one screen, show locations of each on sketch.