

P.R.
 Q 25
 5-11-74

MISSISSIPPI
 BOARD OF WATER COMMISSIONERS
 416 North State Street
 Jackson, Mississippi 39201

CODED

WATER WELL DRILLERS LOG

5-11 1974 East Penton water well serv. Pearl River
 date well completed firm name county well located

LANDOWNER:
John Doyle
Lacombe, LA.
 (mailing address)


description of formations encountered	from	to
Red clay	0	20
White clay	20	38
Blue clay	38	180
Fine blue sd.	180	220
Coarse blue sd.	220	288

WELL LOCATION:
 (36) sec. 7 T. 4 N. R. 16 E.
5 miles (distance) NE (direction) McWell (nearest town)

WELL PURPOSE: Carded home
 (home, irrigation, municipal, industrial)

WELL COMPLETION DATA:
 (1) diameter (inches) 7 1/2
 (2) total depth (feet) 288
 (3) static water level (feet) 93 below/above top of ground.
 (4) casing P.V.C. 268 (material) (depth)
 (size) if telescope see back.
 (5) screen 20' 268 (length) (depth to top)
4 (size) P.V.C. (material)
 (6) pump 2 (HP) 1600 P.H. (yield gpm)
Elect. (type power)
 (7) electric log NO (yes or no)
 (organization running log)
 (8) how well bottom plugged Shoe

CODED

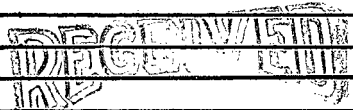


FEB 18 1975

DRILLERS REMARKS:

If well telescopes please sketch and show depths.

GROUND LEVEL

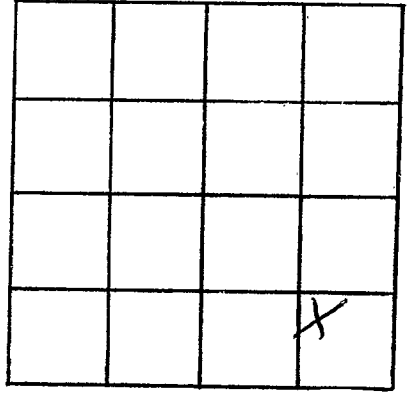

SECTION 36

Please indicate well location X.

ADDITIONAL INFORMATION

If more than one screen, show locations of each on sketch.