

Pearl R.
 Q26
 2-15-75

MISSISSIPPI
 BOARD OF WATER COMMISSIONERS
 416 North State Street
 Jackson, Mississippi 39201

WATER WELL DRILLERS LOG

2-15
 date well completed

1975 Memphis Well Co.
 firm name

Pearl River
 county well located


LANDOWNER:
 Mr. J. H. Kanner
 R. D. Canine, Miss.
 (mailing address)

description of formations encountered	from to	
Clay	0	20
Sand	20	60
Clay	60	155
Sand	155	199

WELL LOCATION:
 sec. 33 T 40 N R 76 E
 2 miles E of McNeil
 (distance) (direction) (nearest town)

WELL PURPOSE: None
 (home, irrigation, municipal, industrial)

- WELL COMPLETION DATA:
- (1) diameter (inches) 2"
 - (2) total depth (feet) 199
 - (3) static water level (feet) 30' below top of ground.
 - (4) casing P.V.C., 191' (material) (depth)
 2" (size) if telescope see back.
 - (5) screen 5' (length), 191' (depth to top)
 2" (size), P.V.C. (material)
 - (6) pump 1/2 (HP), 360 S.P.H. (yield gpm)
 Elec (type power)
 - (7) electric log No. (yes or no)
 - (organization running log)
 - (8) how well bottom plugged Sand/Silt

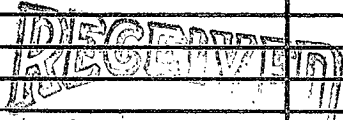


MAR 26 1975

DRILLERS REMARKS:

MISS. BD OF W.C.

If well telescopes please sketch and show depths.

GROUND LEVEL

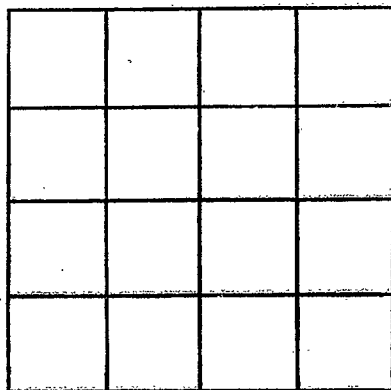

SECTION _____

Please indicate well location X.

ADDITIONAL INFORMATION

If more than one screen,
show locations of each on sketch.