

Pearl River
Q 27
1-27-70

MISSISSIPPI
 BOARD OF WATER COMMISSIONERS
 416 North State Street
 Jackson, Mississippi 39201

COVERED

WATER WELL DRILLERS LOG

1-27 1970 Neil Lumpkin Pearl River
 date well completed firm name county well located

LANDOWNER: Crawford Duggs
M^cNeill, Miss.
Route
 (mailing address)

description of formations encountered	from	to
<u>Surface Clay</u>	<u>0</u>	<u>25</u>
<u>Fines to good sand</u>	<u>25</u>	<u>68</u>

WELL LOCATION:
 sec. 32 T. 4 N. R. 16 E.
 S W
3 miles East of M^cNeill
 (distance) (direction) (nearest town)

WELL PURPOSE: Home
 (home, irrigation, municipal, industrial)

- WELL COMPLETION DATA:
- (1) diameter (inches) 2"
 - (2) total depth (feet) 68
 - (3) static water level (feet) 35 below top of ground.
 - (4) casing plastic, 63
 (material) (depth)
2" if telescope see back.
 (size)
 - (5) screen 5'
 (length) (depth to top)
2", plastic
 (size) (material)
 - (6) pump 1/2 350 feet per hr.
 (HP) (yield gpm)
electric
 (type power)
 - (7) electric log No
 (yes or no)

(organization running log)

(8) how well bottom plugged Johnson
back pressure valve


DRILLERS REMARKS:

JAN 30 1970

MISS. Bd. OF
 WATER COMMISSIONERS

If well telescopes please sketch and show depths.

GROUND LEVEL

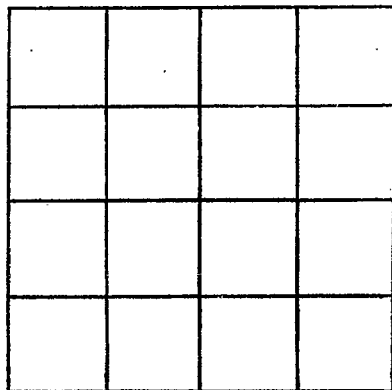

SECTION _____

Please indicate well location X.

ADDITIONAL INFORMATION

If more than one screen,
show locations of each on sketch.