

Pearl River  
Q 28  
4-22-70

MISSISSIPPI  
BOARD OF WATER COMMISSIONERS  
416 North State Street  
Jackson, Mississippi 39201

WATER WELL DRILLERS LOG

4-22  
date well completed

WELL LUMPKIN WELL DRILLING SERVICE  
P. O. BOX 117  
CARRISBEE, MISS.

Pearl River  
county well located


LANDOWNER: <u>Don Breland</u> <u>McNeill, Miss.</u> (mailing address)	description of formations encountered	from	to
	<u>Surface Clay</u>	<u>0</u>	<u>10</u>
	<u>Surface sand &amp; gravel</u>	<u>10</u>	<u>80</u>
	<u>Blue Clay</u>	<u>80</u>	<u>210</u>
	<u>Fine to better sand</u>	<u>210</u>	<u>258</u>
WELL LOCATION: sec. <u>7</u> T. <u>4</u> R. <u>16</u> <u>074</u> <u>3 1/2</u> miles <u>W.</u> of <u>McNeill</u> (distance) (direction) (nearest town)			
WELL PURPOSE: (home, irrigation, municipal, industrial)			
WELL COMPLETION DATA:			
(1) diameter (inches) <u>2"</u>			
(2) total depth (feet) <u>258</u>			
(3) static water level (feet) <u>0</u> <u>slight flow</u> below above top of ground.			
(4) casing <u>galv.</u> (material) (depth) <u>2"</u> (size) if telescope see back.			
(5) screen <u>5'</u> (length) (depth to top) <u>2"</u> (size) <u>St. Steel</u> (material)			
(6) pump <u>1/2</u> (HP) <u>600</u> (yield gpm) <u>electric</u> (type power)			
(7) electric log <u>no</u> (yes or no)			
(organization running log)			
(8) how well bottom plugged <u>Johnson</u> <u>B.P. Vals</u>			
DRILLERS REMARKS: <u>0 water level</u>			

JUN 1 1970

MISS. BD. OF  
WATER COMM.

If well telescopes please sketch and show depths.

GROUND LEVEL

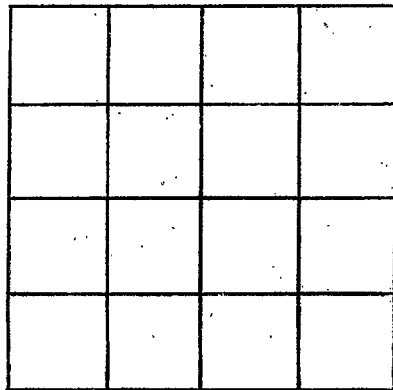

SECTION \_\_\_\_\_

Please indicate well location X.

ADDITIONAL INFORMATION

If more than one screen, show locations of each on sketch.