

Pearl River
Q 30
4-18-70

MISSISSIPPI
 BOARD OF WATER COMMISSIONERS
 416 North State Street
 Jackson, Mississippi 39201

WATER WELL DRILLERS LOG

NEIL LUMPKIN WELL DRILLING SERVICE
 P. O. BOX 117
 CARRIERS, MISS.
 firm name

Pearl River
 county well located

4-18-1970
 date well completed

LANDOWNER: James P. Hayes
M^cNeill

| description of formations encountered | from | to |
|---------------------------------------|-----------|-----------|
| <u>Surface Clay</u> | <u>0</u> | <u>10</u> |
| <u>Fine to perfect sand</u> | <u>10</u> | <u>56</u> |

(mailing address)

WELL LOCATION: 074
 sec. 32 T. 4 S. R. 16 W.
1 1/2 miles SE of M^cNeill
 (distance) (direction) (nearest town)

WELL PURPOSE: home
 (home, irrigation, municipal, industrial)

WELL COMPLETION DATA:

- diameter (inches) 2"
- total depth (feet) 56
- static water level (feet) 20 below above top of ground.
- casing plastic
 (material) (depth)
2"
 (size) If telescope see back.
- screen 5
 (length) (depth to top)
2" plastic
 (size) (material)
- pump 1/2 450 gph
 (HP) (yield gpm)
electric
 (type power)
- electric log no
 (yes or no)

(organization running log)

(8) how well bottom plugged Johnson
R-P Valve


DRILLERS REMARKS:
4

JUN 1 - 1970

MISS. BD. OF
 WATER COM.

If well telescopes please sketch and show depths.

GROUND LEVEL

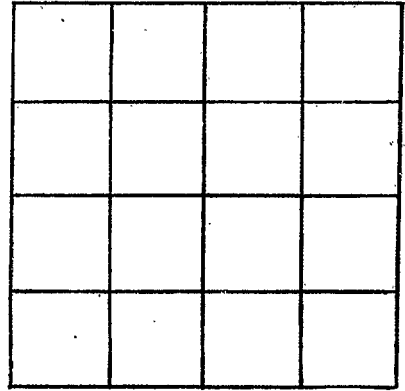

SECTION _____

Please indicate well location X.

ADDITIONAL INFORMATION

If more than one screen, show locations of each on sketch.