

CODED

MISSISSIPPI
BOARD OF WATER COMMISSIONERS
416 North State Street
Jackson, Mississippi 39201

WATER WELL DRILLERS LOG

Pearl River

Pearl River
Q 32
5-20-70

5-20 19 *70* *BJT water well serd.*
date well completed firm name county well located

LANDOWNER:

McNeil First
Baptist Church
McNeil Miss.
(mailing address)

description of formations encountered

	from	to
<i>Red clay</i>	<i>0</i>	<i>14</i>
<i>white clay sd.</i>	<i>14</i>	<i>21</i>
<i>Red & white clay</i>	<i>21</i>	<i>35</i>
<i>Med. Red. sd.</i>	<i>35</i>	<i>55</i>
<i>Red clay</i>	<i>55</i>	<i>99</i>
<i>Blue clay</i>	<i>99</i>	<i>196</i>
<i>med. Gray sd.</i>	<i>196</i>	<i>212</i>

WELL LOCATION:

sec. *32* T *4* N R *16* E
1/2 miles *E* of *McNeil*
(distance) (direction) (nearest town)

WELL PURPOSE:

Home
(home, irrigation, municipal, industrial)

WELL COMPLETION DATA:


- (1) diameter (inches) *4 5/8*
- (2) total depth (feet) *212*
- (3) static water level (feet) *131* below top of ground.
- (4) casing *Galv.* (material) *207* (depth)
(size) if telescope see back.
- (5) screen *5'* (length) *207-12* (depth to top)
2" (size) *S.S.* (material)
- (6) pump *1* (HP) *250* (yield gpm) *117*
Elect (type power) *A*
- (7) electric log *NO* (yes or no)
(organization running log)
- (8) how well bottom plugged *5000*

CODED

DRILLERS REMARKS:

If well telescopes please sketch and show depths.

GROUND LEVEL

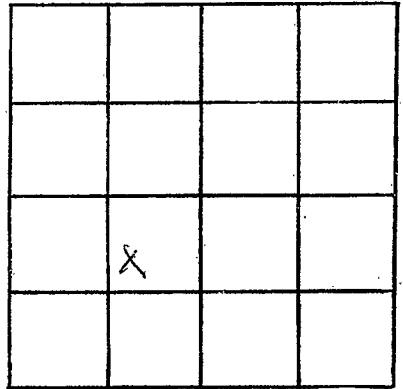

SECTION 32

Please indicate well location X.

ADDITIONAL INFORMATION

If more than one screen,
show locations of each on sketch.