

PEARL RIVER
Q 33
9-1-70

MISSISSIPPI
BOARD OF WATER COMMISSIONERS
416 North State Street
Jackson, Mississippi 39201

CODED

WATER WELL DRILLERS LOG

9-1-1970 EST 2000 Terrell (S.W.) Pearl River
date well completed firm name county well located

LANDOWNER:
Don Sares
McNeil, MISS.
(mailing address)

description of formations encountered	from	to
yellow & red clay	0	18
Blue white clay	18	32
Blocky sand	32	79
Blue clay	79	195
Fine Blue kd.	195	240
Grey Co. sd. & gravel	240	260

WELL LOCATION:
sec. 4 T 4 N R 16 E
3 miles north of McNeil
(distance) (direction) (nearest town)

WELL PURPOSE: home
(home, irrigation, municipal, industrial)

- WELL COMPLETION DATA:
- (1) diameter (inches) 4 5/8
 - (2) total depth (feet) 258
 - (3) static water level (feet) 38 below top of ground.
 - (4) casing Co. W. 253
(material) (depth)
2" if telescope see back.
(size)
 - (5) screen 5' 253-258
(length) (depth to top)
2 S.S.
(size) (material)
 - (6) pump 1 400
(HP) (yield gpm)
Elect
(type power)
 - (7) electric log No
(yes or no)
 - (organization running log)
 - (8) how well bottom plugged Shoe

CODED


OCT 13 1970

MISS. BD. OF
WATER COMM.

DRILLERS REMARKS:

If well telescopes please sketch and show depths.

GROUND LEVEL

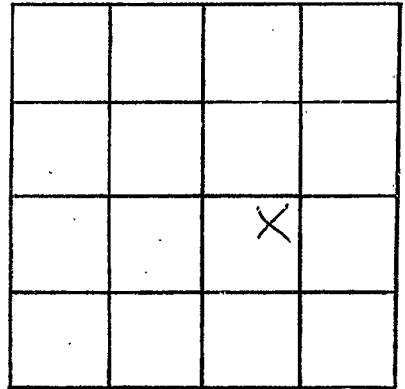

SECTION 8

Please indicate well location X.

ADDITIONAL INFORMATION

If more than one screen, show locations of each on sketch.