

PEARL RIVER

Q34

9-12-70

MISSISSIPPI BOARD OF WATER COMMISSIONERS
416 North State Street
Jackson, Mississippi 39201

CODED

WATER WELL DRILLERS LOG

NEIL LUMPKIN WELL DRILLING SERVICE

P. O. BOX 117

CARRIAGE, MISS.

Pearl River

9-12

19 *70*

date well completed

firm name

county well located

LANDOWNER: *James Spiers*

McNeil Truck Stop

description of formations encountered

from

to

Surface Clay

0

20

(mailing address)

Surface sand, good

20

40

WELL LOCATION:

sec. *34* T. *4* S. R. *16* W.

white + blue clay

40

270

3 1/2 miles *East* of *McNeil*
(distance) (direction) (nearest town)

Good sand (has marine bacteria in it)

270

363

WELL PURPOSE: *ROB*
(home, irrigation, municipal, industrial)

Blue clay

363

700

WELL COMPLETION DATA:

Good sand

700

746

(1) diameter (inches) *4 X 2"*

(2) total depth (feet) *746*

(3) static water level (feet) *84'* below top of ground.

(4) casing *galv.* (material) (depth) *126'*

? *510'* (size) if telescope see back.

(5) screen *10'* (length) (depth to top)

2" (size) *St. Steel* (material)

(6) pump *5* (HP) *100 gpm* (yield gpm)

electric (type power)

(7) electric log *No.* (yes or no)

(organization running log)

(8) how well bottom plugged *Johnson*

CODED


NOV 3 1970

DRILLERS REMARKS:
1000 gal. Tank

MISS. BD. OF WATER COMM.

If well telescopes please sketch and show depths.

GROUND LEVEL

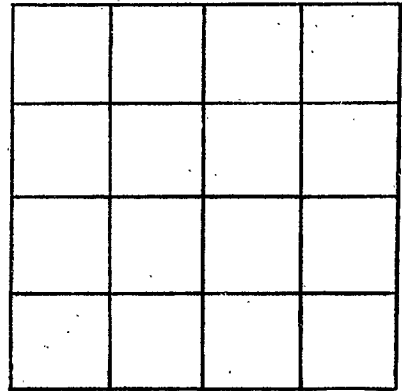

SECTION _____

Please indicate well location X.

ADDITIONAL INFORMATION

If more than one screen, show locations of each on sketch.